


T.3N. R.1W. Section 32, W.M.

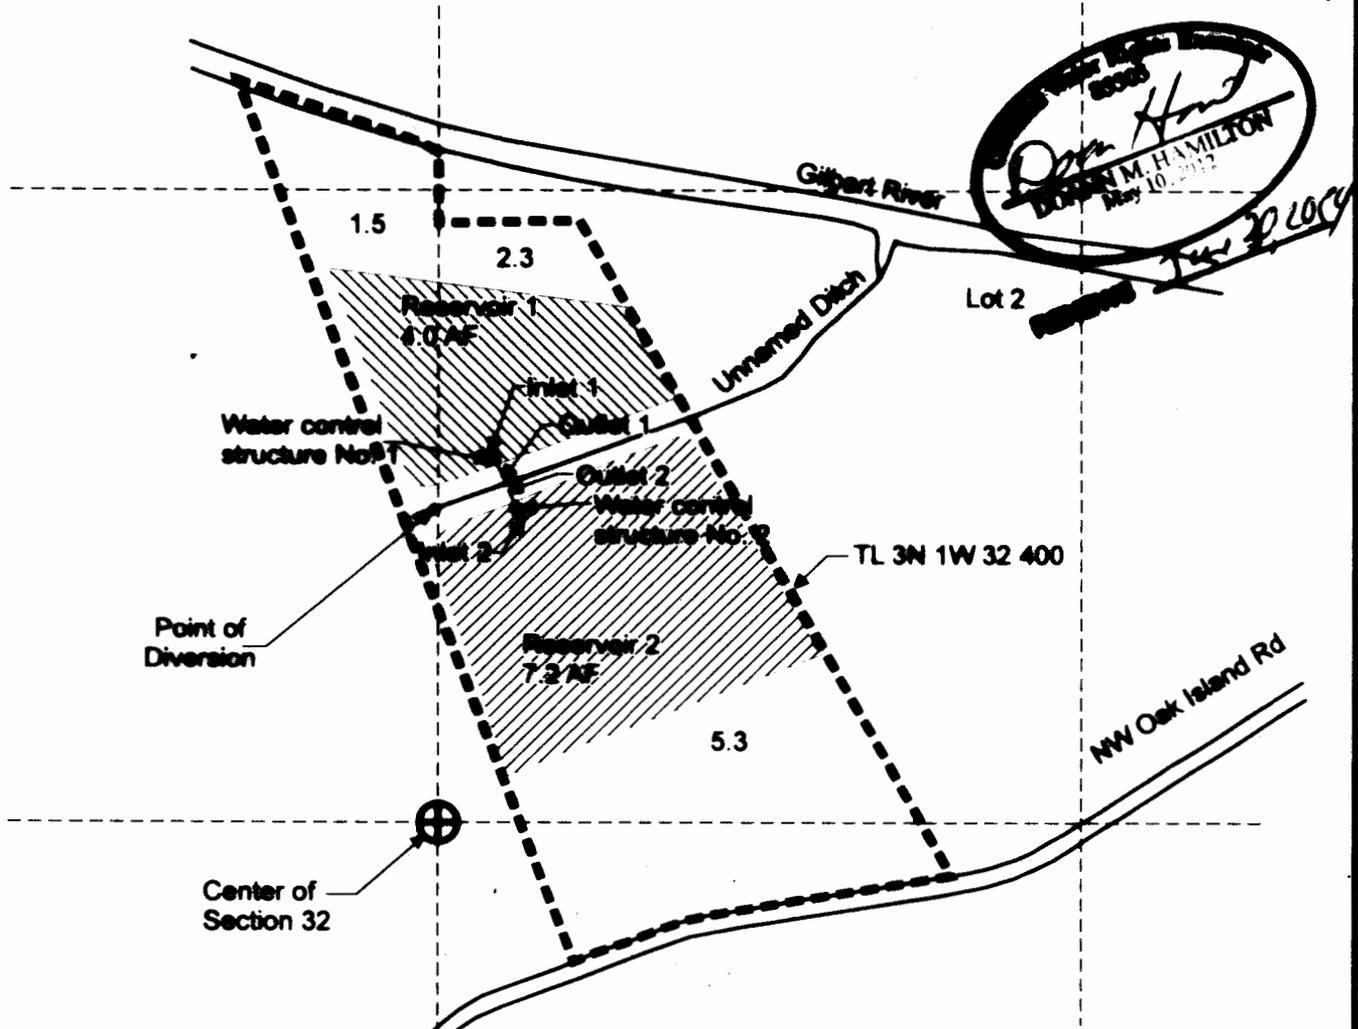

Reservoir 1 outlet is located 720 feet north and 130 feet east from the center of Section 32, Lot 2.
 Reservoir 2 outlet is located 655 feet north and 160 feet east from the center of Section 32, Lot 2.
 Point of Diversion is located 655 feet north and 10 feet west from the center of Section 32.

- Reservoir 1 area (3.8 acres, 4.0 AF) impounded by Application R-87807, Permit R-15013
- Reservoir 2 area (5.3 acres, 7.2 AF) impounded by Application R-87807, Permit R-15013
- Tax Lot Boundary


RECEIVED

OCT 22 2014

WATER RESOURCES DEPT
 SALEM, OREGON

This map was prepared for the purpose of identifying the location of a water right only and is not intended to provide legal dimensions or location of property ownership lines.

Scale: 1" = 400'

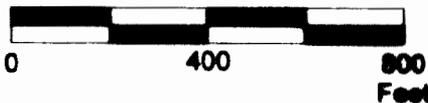

Claim of Beneficial Use Map
 Application R-87807, Permit R-15013

Hollow Goose Farm LLC
 T.3N. R.1W. Section 32, W.M.

Pacific Hydro-Geology Inc.

05/2014, 10/2014 rev