


CLAIM OF BENEFICIAL USE MAP

APPLICATION R-86646 PERMIT R-14399

CONSTRUCT RESERVOIR & STORE PUBLIC WATERS - TYLER RESERVOIR
FOR


TRENT NISTLER
121 GENESSEE STREET
MEDFORD, OREGON 97504

SITUATED IN
SECTIONS 29, TOWNSHIP 35 SOUTH, RANGE 2 WEST, W.M.
JACKSON COUNTY, OREGON

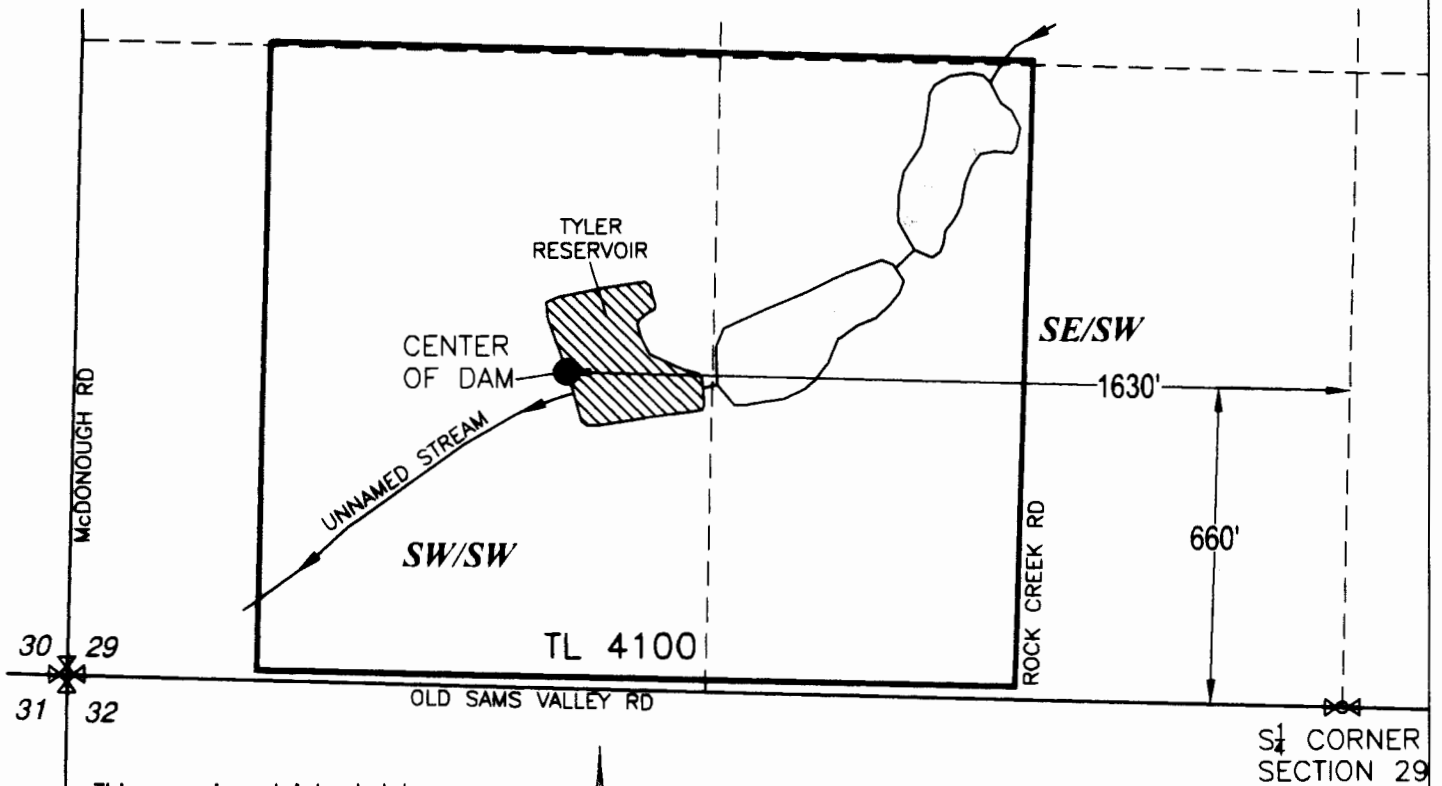

This map is not intended to
provide legal dimensions or
locations of property
ownership lines.

EHM-July 10, 2014
RH2 ENGINEERING, INC.
www.rh2.com 1.800.720.8052

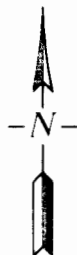

0 200 400
SCALE: 1"=400'

LEGEND




CENTER OF DAM
1630' WEST AND 660' NORTH OF
S 1/4 CORNER SECTION 29



1/4-1/4 SECTION LINE



RESERVOIR

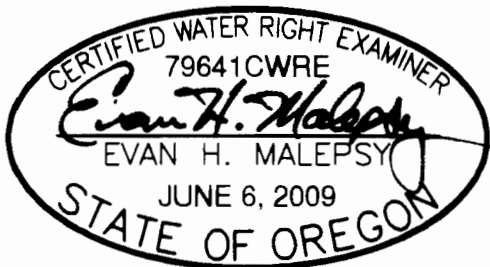

RENEWS: 12/31/2014