


TOWNSHIP 14 SOUTH, RANGE 21 EAST, W.M.

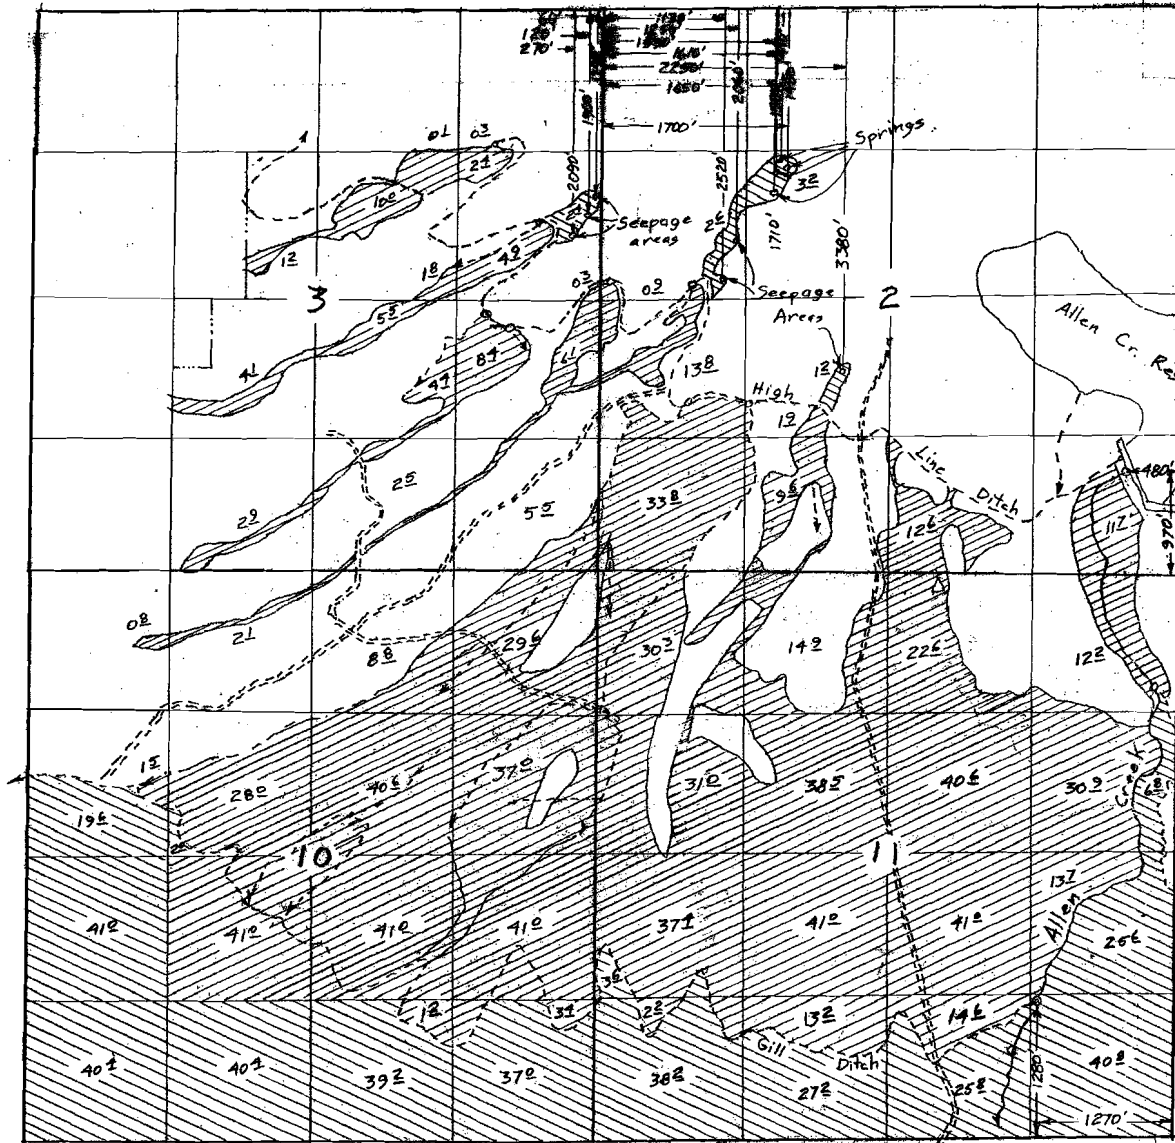

Claim of Beneficial Use Map
for
Les Schwab Tire Centers of Oregon
(LS Ranch portion of Allen Creek
and Springs/Seepage Areas under
application 30100, permit 24774)

- ⊗ Allen Creek (1193.6 acres)
- ⊗ Springs/Seepage Areas (94 acres)


Scale 1"=1320'

Surveyed August 14 & September 9 & 10, 2003

RECEIVED

JUN 01 2005

WATER RESOURCES DEPT
SALEM, OREGON

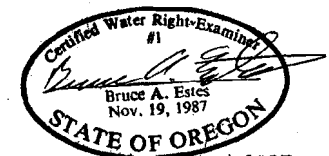

Renewal Dec 31, 2003

This map is for the purpose of
locating a water right only
and has no intent to provide
legal dimensions or the location
of property lines.

ESTES SURVEYS, LLC

PO Box 17519 80382 Arnold Rd
Salem, OR 97305-7519 Bend, OR 97702
(503) 585-7593 (541) 382-7391

Amended 28 May 05

