

- INDIAN CR. & UNN. TRIG, STUMP CR., FOX CR., ELLIOTT CR. & E. F.K. ELLIOTT CR.
- HOWARD CR., CRAM CR., JOHNSON CR. & BRUSH CR.
- NORTH FORK CROOKED RIVER
- ALLEN CR. & ALLEN CR. RESERVOIR *
- PETERSON CR. & PETERSON CR. RESERVOIR

* LANDS IRRIGATED FROM FOX AND ELLIOTT CREEKS ALSO IRRIGATED FROM ALLEN CREEK RESERVOIR.

PRIMARY IRRIGATION UNDER THESE PERMITS PRIOR RIGHTS

DIVERSION POINTS LOCATED:

- 800 FT. S. AND 280 FT. W. FROM W 1/4 COR. SEC. 36 T. 13 S. R. 20 E. W.M.
- 310 FT. N. AND 320 FT. E. FROM W 1/4 COR. SEC. 31 T. 13 S. R. 20 E. W.M.
- 1030 FT. S. AND 100 FT. W. FROM S 1/4 COR. SEC. 32 T. 13 S. R. 21 E. W.M.
- 360 FT. S. AND 180 FT. W. FROM N 1/4 COR. SEC. 12 T. 14 S. R. 21 E. W.M.
- 630 FT. S. AND 850 FT. W. FROM E 1/4 COR. SEC. 12 T. 14 S. R. 21 E. W.M.
- 500 FT. N. AND 520 FT. W. FROM SE COR. SEC. 13 T. 14 S. R. 21 E. W.M.
- 310 FT. N. AND 710 FT. E. FROM SW COR. SEC. 14 T. 14 S. R. 21 E. W.M.
- 180 FT. N. AND 950 FT. E. FROM SW COR. SEC. 14 T. 14 S. R. 21 E. W.M.
- 970 FT. N. AND 480 FT. W. FROM SE COR. SEC. 2 T. 14 S. R. 20 E. W.M.
- 90 FT. S. AND 800 FT. W. FROM N 1/4 COR. SEC. 3 T. 14 S. R. 20 E. W.M.
- 800 FT. S. AND 180 FT. W. FROM N 1/4 COR. SEC. 3 T. 14 S. R. 20 E. W.M.
- 1820 FT. S. AND 1110 FT. E. FROM W 1/4 COR. SEC. 3 T. 14 S. R. 20 E. W.M.
- 870 FT. S. AND 220 FT. E. FROM W 1/4 COR. SEC. 3 T. 14 S. R. 20 E. W.M.
- 810 FT. N. AND 3070 E. FROM W 1/4 COR. SEC. 7 T. 14 S. R. 20 E. W.M.
- 320 FT. S. AND 280 FT. W. FROM SE COR. SEC. 9 T. 14 S. R. 20 E. W.M.
- 320 FT. S. AND 890 FT. W. FROM NE COR. SEC. 11 T. 14 S. R. 20 E. W.M.
- 1020 FT. S. AND 150 FT. W. FROM NE COR. SEC. 11 T. 14 S. R. 20 E. W.M.
- 101 FT. N. AND 650 FT. E. FROM SW COR. SEC. 14 T. 14 S. R. 21 E. W.M.
- 1870 FT. S. AND 280 FT. W. FROM NE COR. SEC. 16 T. 14 S. R. 21 E. W.M.
- 2250 FT. S. AND 500 FT. E. FROM N 1/4 COR. SEC. 12 T. 14 S. R. 21 E. W.M.
- 830 FT. S. AND 1400 FT. W. FROM NE COR. SEC. 17 T. 14 S. R. 21 E. W.M.
- 5000 FT. S. AND 850 FT. E. FROM NW COR. SEC. 19 T. 14 S. R. 21 E. W.M.
- 160 FT. N. AND 280 FT. W. FROM E 1/4 COR. SEC. 29 T. 14 S. R. 21 E. W.M.

FINAL PROOF SURVEY

UNDER


Application No. R-28664 Permit No. R-1554

28665	22573
29712	23391
R-29713	R-1710
29714	23392
30100	24774
R-30753	R-2000
30754	24775
R-46546	R-5479
46547	34405

IN NAME OF
BOSTON RANCH COMPANY

SURVEYED Jun. 22 thru Jul. 3, 1970 by D. Buell
INSPECTED Oct. 1968 by L. E. Gould
Jul. 1963 by T. Lauer
Sep. 1960 by R. Jackson

TOWNSHIP 14 SOUTH, RANGE 21 EAST, W.M.

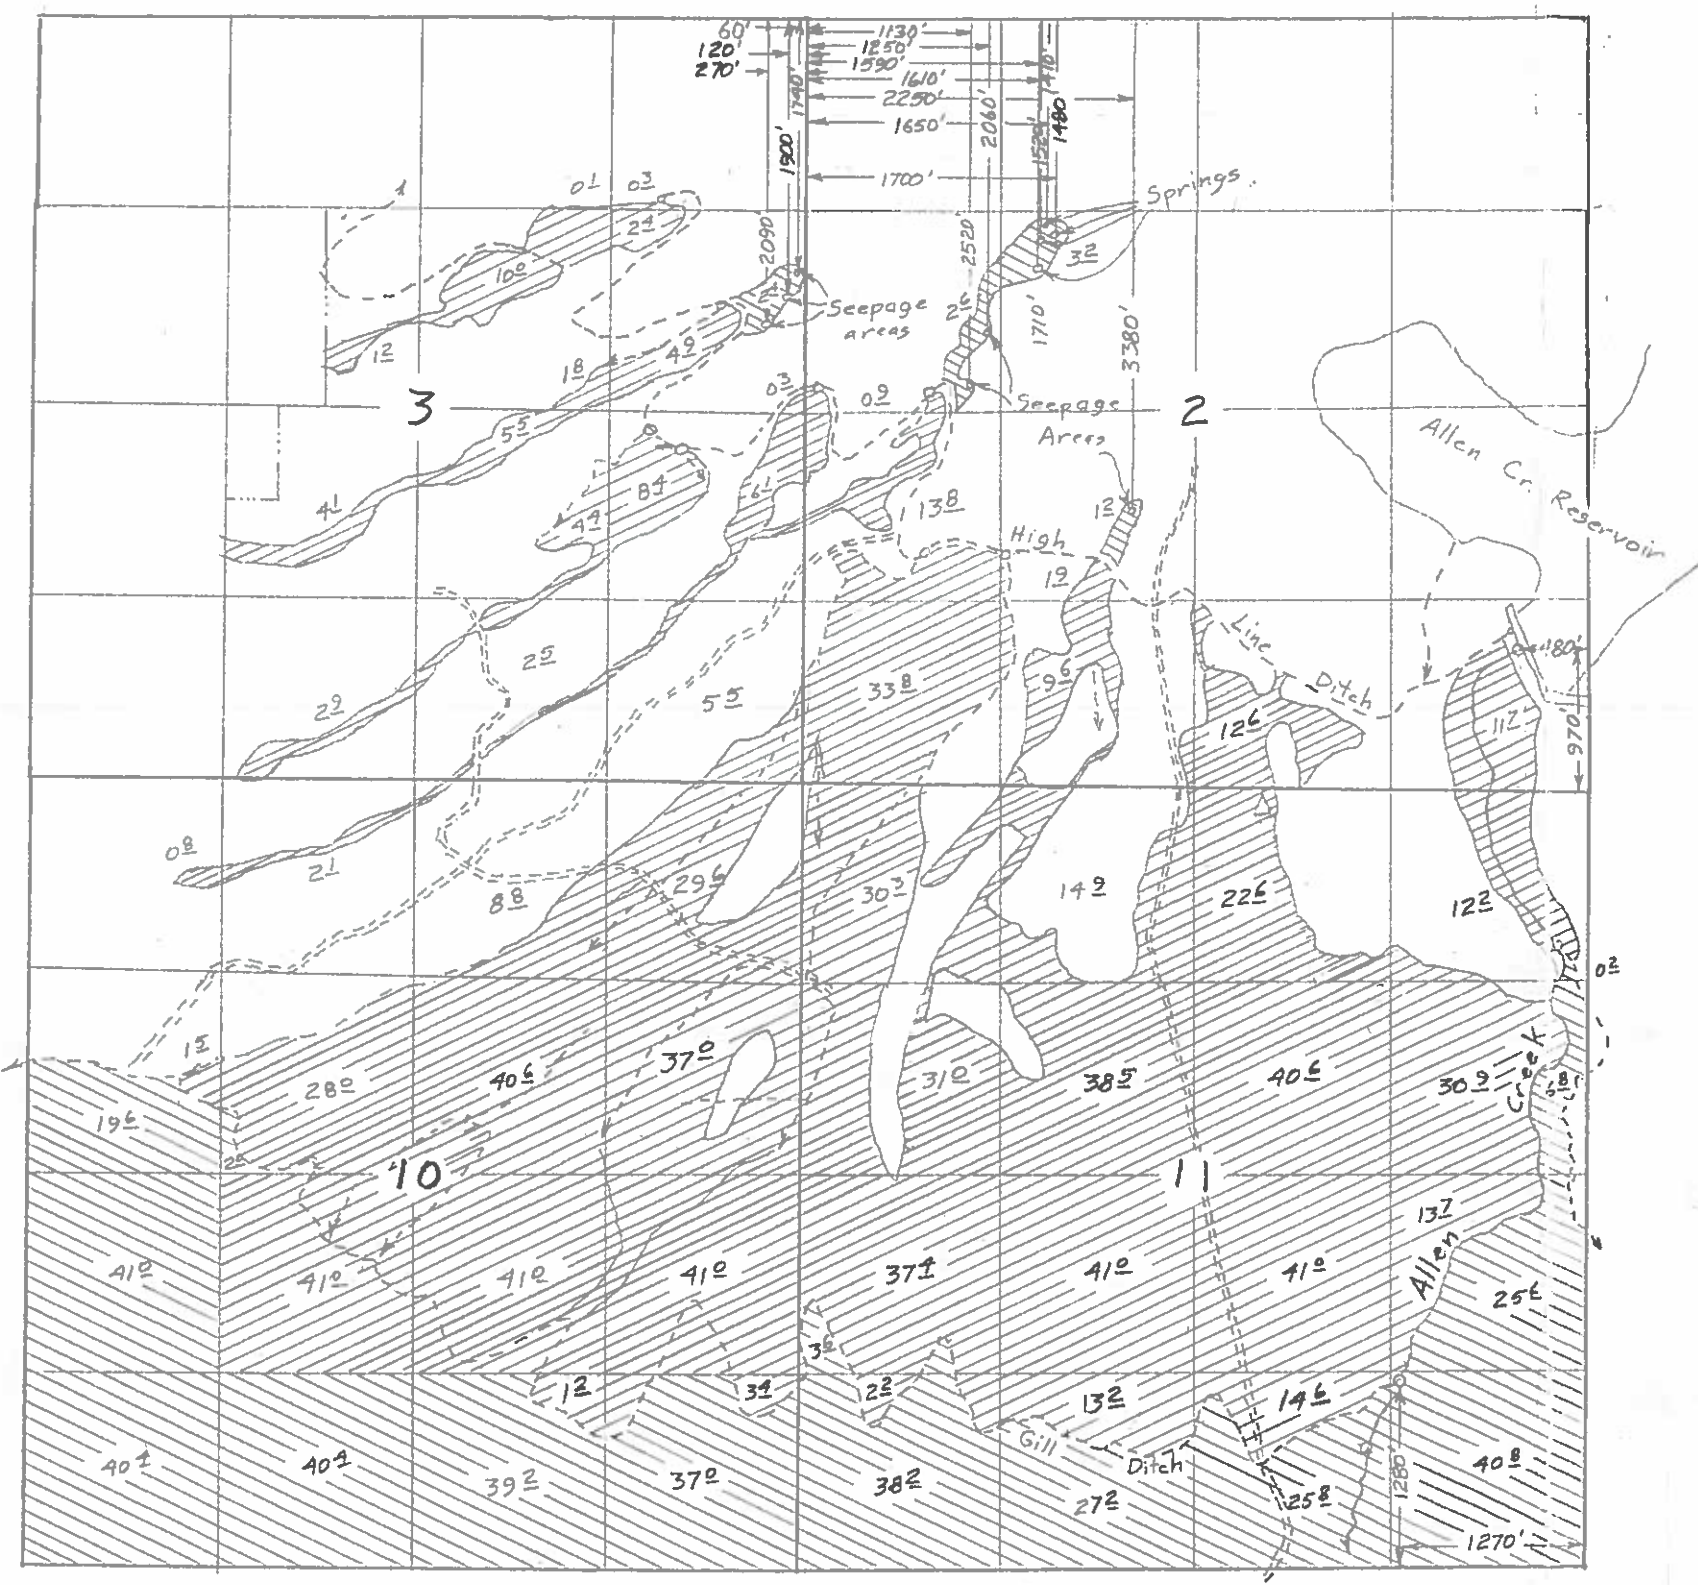

Claim of Beneficial Use Map
for
Les Schwab Tire Centers of Oregon
(LS Ranch portion of Allen Creek
and Springs/Seepage Areas under
application 30100, permit 24774)

- ⊗ Allen Creek (1193[±] acres)
- ⊗ Springs/Seepage Areas (94 acres)

Scale 1"=1320'

RECEIVED
JUN 01 2005
WATER RESOURCES DEPT
SALEM, OREGON

Certified Water Right Examiner
#1
Bruce A. Estes
Bruce A. Estes
Nov. 19, 1987
STATE OF OREGON
Renewal Dec 31, 2003

Surveyed August 14 & September 9&10, 2003

This map is for the purpose of
locating a water right only
and has no intent to provide
legal dimensions or the location
of property lines.

ESTES SURVEYS, LLC
PO Box 17519 60382 Arnold Rd
Salem, OR 97305-7519 Bend, OR 97702
(503) 585-7593 (541) 382-7391

Amended 28 May 05