

**CLAIM OF BENEFICIAL USE**

TO APPROPRIATE THE PUBLIC WATERS  
 Section 17, Twp 7S, Range 4W  
 Tax Lot # 100 (7-4-17 & 20)  
 Polk County, Oregon  
 FOR: Mark Knaupp  
 Application # S-84626 Permit # S-53800  
 Date Surveyed: Feb.6, 2004

**SOURCE:**  
 Mud Slough Reservoir #1, constructed under  
 Application No. R-84301, Permit No. R-12878,  
 a tributary of Mud Slough.


**CONVEYANCES:**  
 Transfer System:  
 Motor: World Energy Guardian (WEG), Madras, OR  
 Model: 00718EP3E213T  
 Horsepower: 7.5 HP  
 Max. RPM: 1800  
 Voltage: 480V-3 ph

Pump: Meuret Pump, Inc., Madras, OR  
 Model: 00-9-1  
 Type: Centrifugal Lift Pump  
 Intake/discharge size: 12"/10"  
 Operating Pt.: 1170 gpm @ TDH=15'

Pipe: ~1400 LF of 10" diameter PVC pipe

**PLACE OF USE:**  
 SESW : NESE, NWSE, SWSE, SESE of Sec. 17,  
 T7S, R4W, W.M.  
 NENE, NWNE, SWSE, SESE of Sec. 20, T7S, R4W,  
 W.M.

**NOTE:**  
 Map is for purpose of identifying location of  
 Water Right and has not intent to dimension or  
 locate property ownership lines.  
 The final proof survey and inspection of the water use as found to  
 be completed under the terms and conditions of Permit #S-53800  
 was completed by me on March 22, 2004, and the facts contained  
 in this report and map are correct to the best of my knowledge.

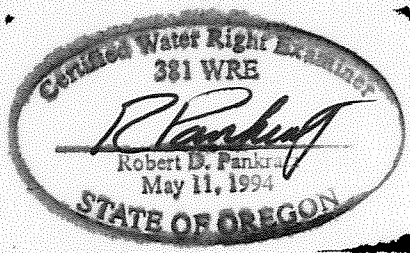


Bob Pankratz, PE, CWRE  
 Water Right Examiner

**POINT OF DIVERSION: (POD)**  
 A 12" diameter "screened" intake pipe  
 placed in Mud Slough within the SE1/4,  
 SE 1/4, Sec.17, T7S, R4E, Sec. 17, WM,  
 Polk County, Oregon; approximately 30-ft  
 north and 255-ft west from the SE  
 corner of Sec.17.

UTM Coord: 100484701 E  
 4977863 N

**RECEIVED**  
 APR 09 2004  
 WATER RESOURCES DEPT  
 SALEM, OREGON

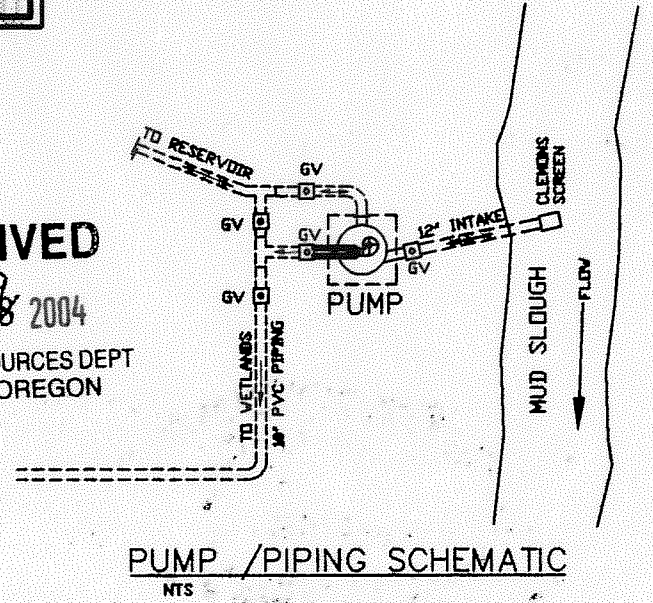

PIONEER ENGINEERING CORP. 4828 Copper Glen Ct. SE - Salem, OR 97302 PioneerEngineering@comcast.net (503)381-2348 FAX (503)381-2867	
Mark Knaupp Water Right 1876 Greenwood Rd N Rickreall, OR 97371 Permit # S-53800 Final Proof Map to Appropriate Water	DESCRIPTION DATE REV. NO. DRAWN: BP CHK'D: BP DATE: April 9, 2004 JOB NO: WATR-0402 SHEET: 1/4