


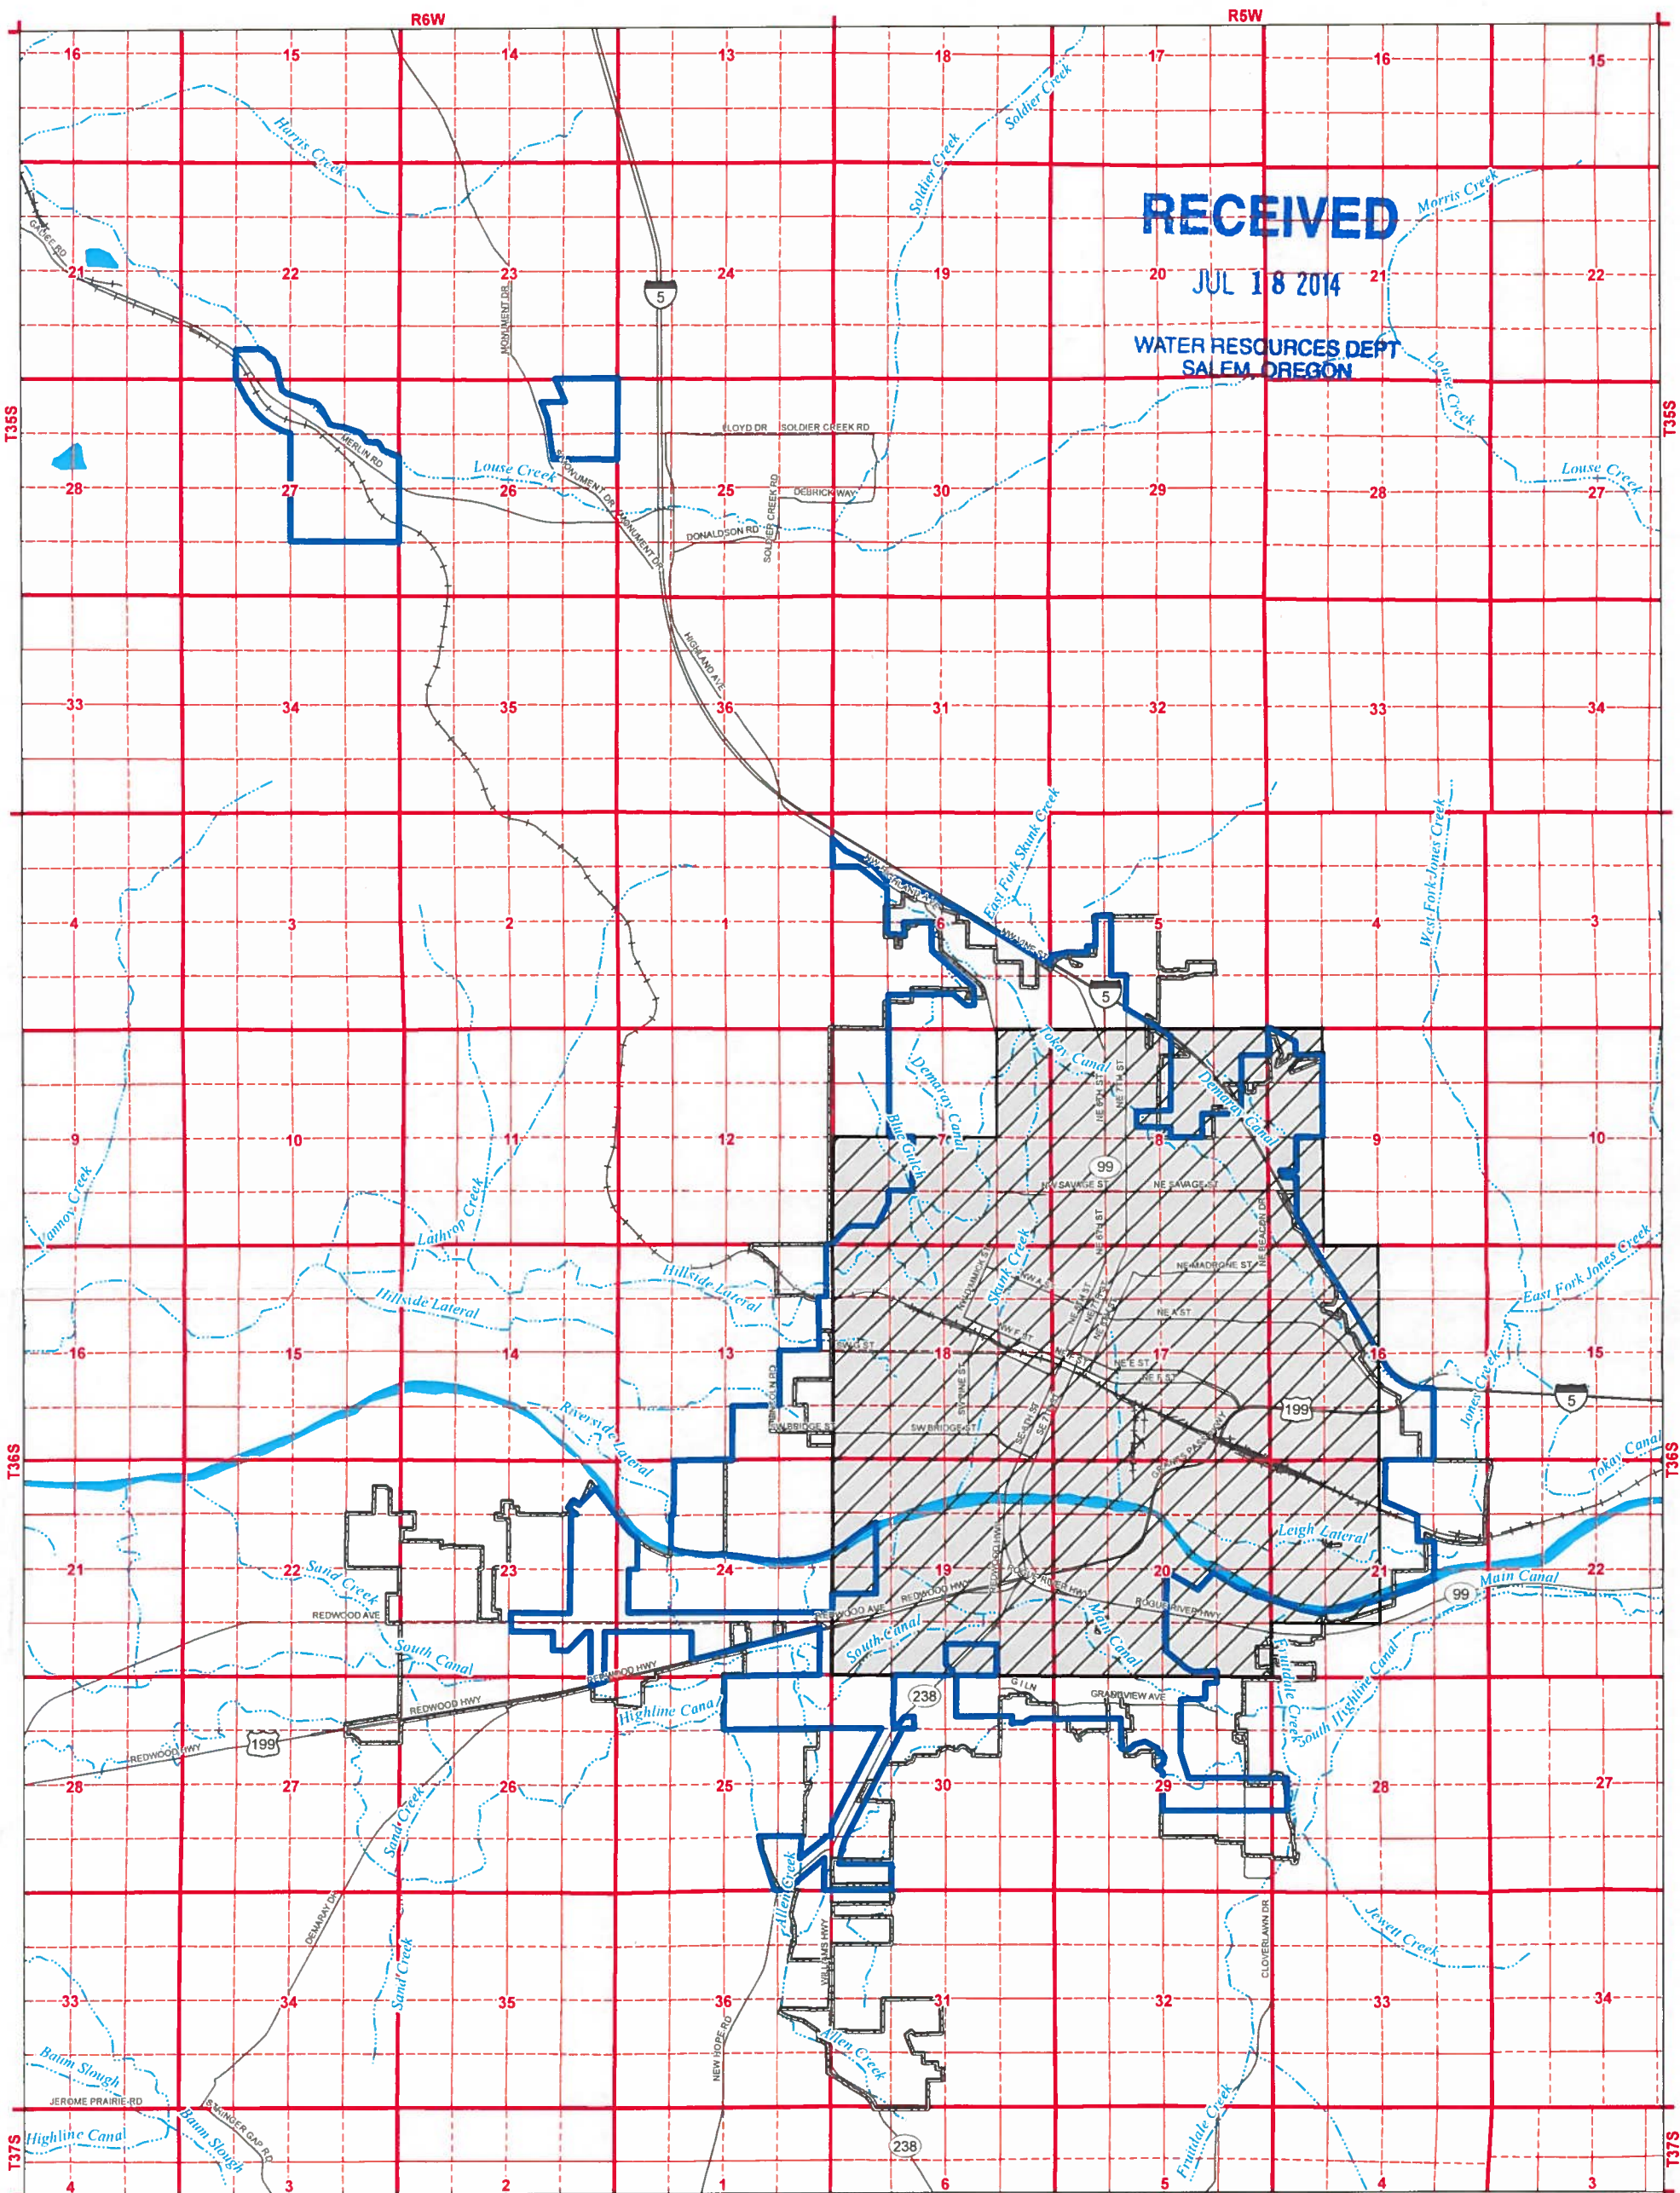

LEGEND


- Place of Use (POU)
- Water Service Area Boundaries
- City of Grants Pass City Limits
- Major Roads
- Railroads
- Watercourses
- Waterbodies

DISCLAIMER

This map was prepared for the purpose of identifying the location of a water right only and it is not intended to provide legal dimensions or location of property ownership lines.

MAP NOTES:

Date: May 27, 2014
Data Sources: City of Grants Pass, OWRD, US BLM, ESRI

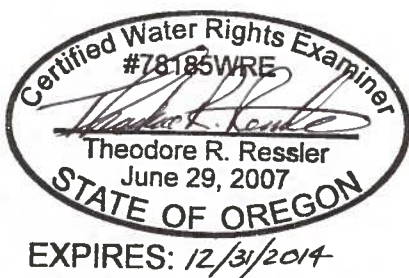

Partial Perfection Claim of Beneficial Use Place of Use Map

Permit S-26901 (Application S-34141)

Water Right in the Name of City of Grants Pass



0 2,000 4,000 6,000
1 inch = 4,000 feet

