



SECTION 13, TWP.4 S. RANGE 13 E. W.M. WASCO COUNTY, OREGON

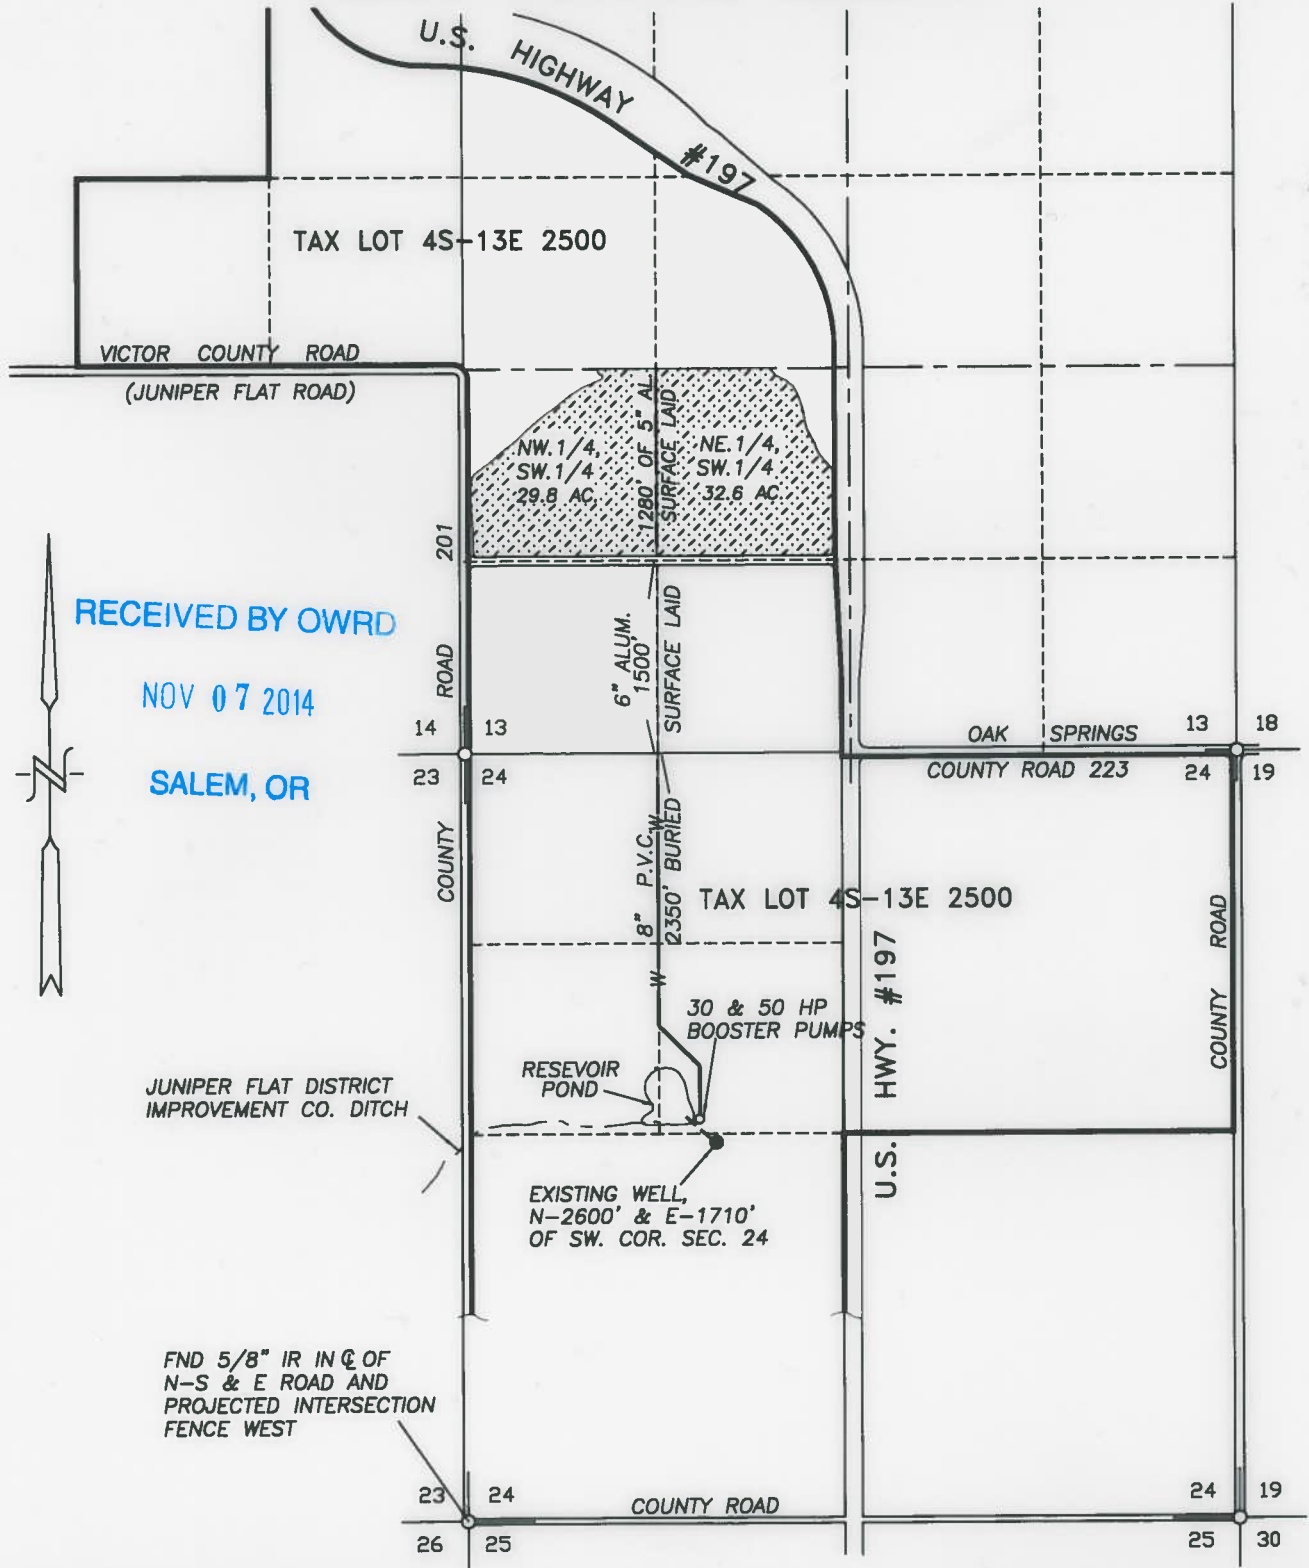

WATER RIGHT FINAL PROOF SURVEY MAP

SCALE: 1" = 1320'

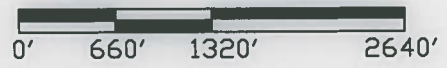

APPLICATION No. G-13439
 PERMIT No. G-12391
 IN THE NAME OF:
 ROBERT LARSELL

