


T. 18S., R. 30E., W.M.
GRANT CO., ORE.

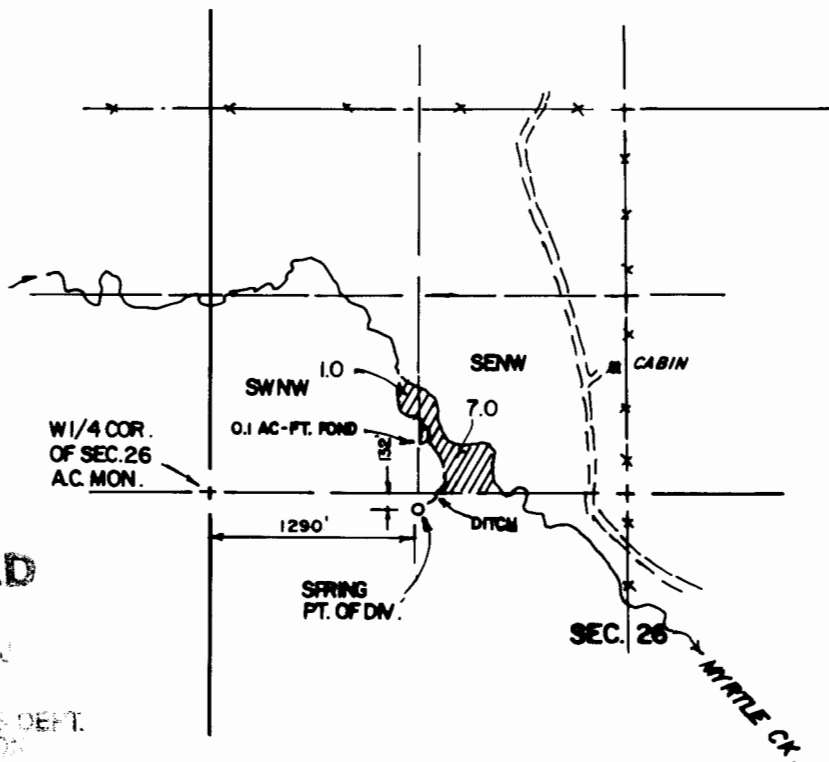

RECEIVED

SEP 8 8 2000

WATER RIGHTS DEPT.

THE PURPOSE OF THIS MAP IS TO
IDENTIFY THE LOCATION OF THE
WATER RIGHT. IT IS NOT INTENDED
TO PROVIDE INFORMATION RELATIVE
TO THE LOCATION OF PROPERTY
OWNERSHIP.

RECEIVED 1/1/01	TOM CLEMENS		BURNS, OREGON	
	FINAL PROOF MAP			
	UNDER APPLICATION S-71104 & PERMIT 52776			
	Scale: 1" = 1320'	Date: SEPT. 2000	Job: -	
	Dsn: -	M.A. PALMER & SONS, INC. ENGINEERING & SURVEYING 711 Ponderosa Village • Box 61 Burns, Oregon 97720		
Dm: CORK	Sht. No. 1			
Ckd: "	of 1			