



THIS MAP WAS PREPARED FOR THE PURPOSE OF IDENTIFYING
THE LOCATION OF THE WATER RIGHT AND IS NOT INTENDED
TO PROVIDE LEGAL DIMENSIONS OR LOCATIONS OF PROPERTY
OWNERSHIP LINES.

T2S, R7W

RECEIVED

DEC 18 1996

WATER RESOURCES DEPT.
SALEM, OREGON

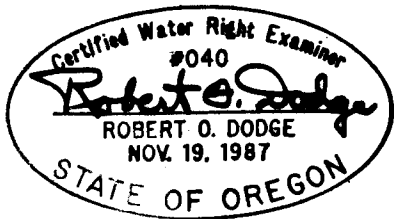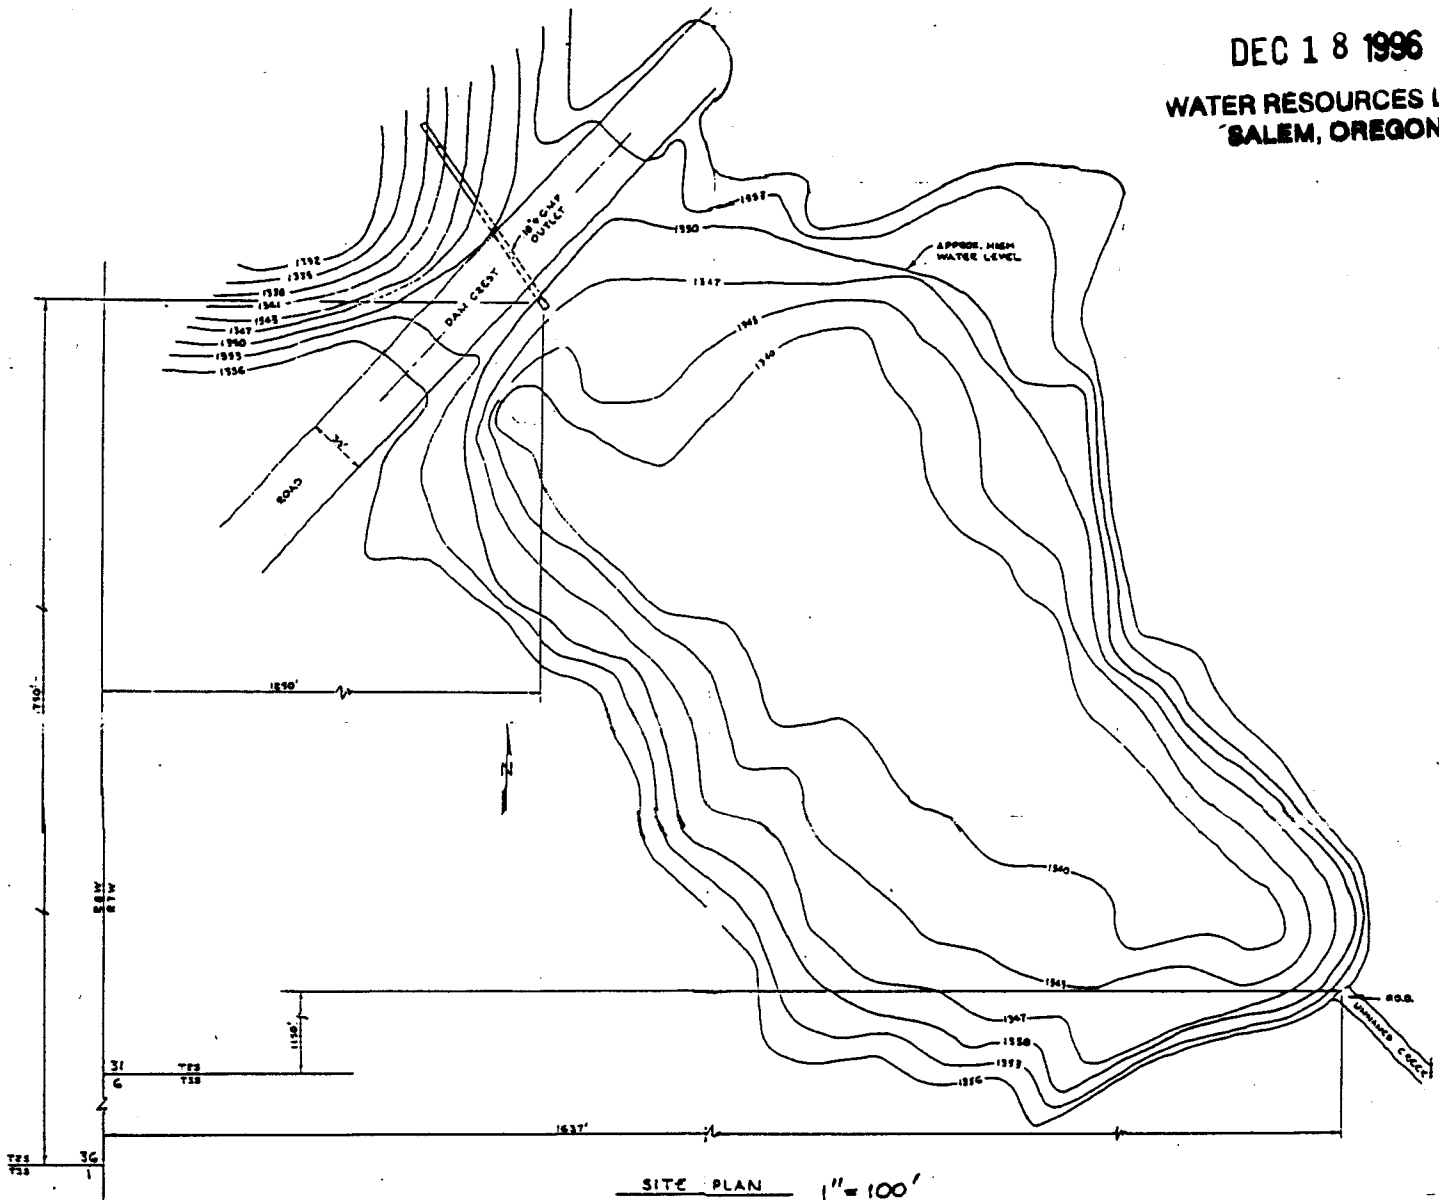

**FINAL PROOF SURVEY
UNDER**

APPLICATION NO. **R-71707** PERMIT NO. **R-11921**
IN NAME OF

OREGON DEPARTMENT OF FISH AND WILDLIFE

SURVEYED: **12/11/96** BY: **DODGE**