


T 3S R 39 E

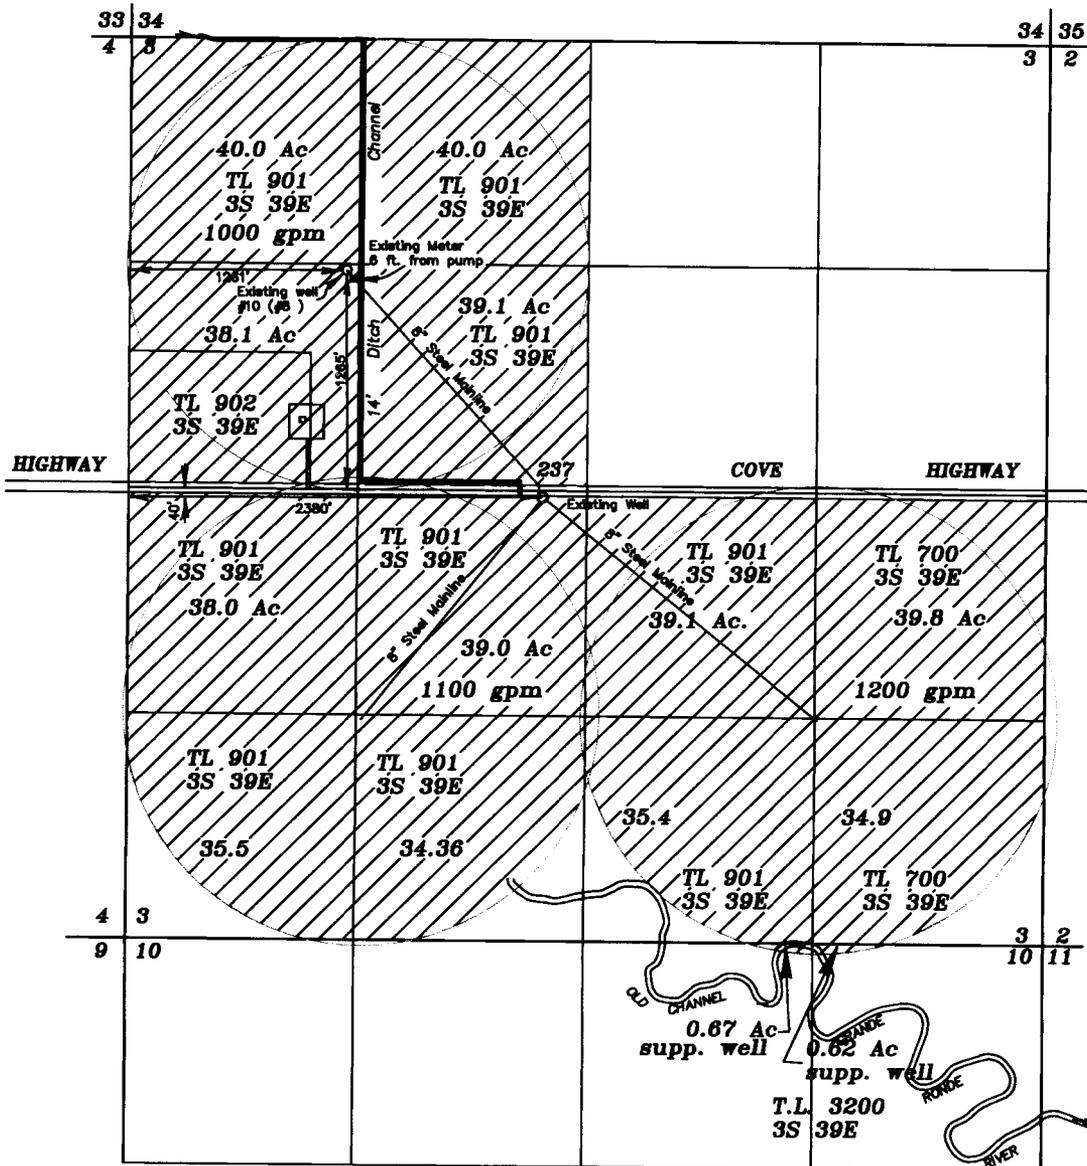

SCALE: 1"=1320'

RECEIVED BY OWRD

JUN 09 2014


SALEM, OR

 Lands being irrigated with Supplemental water from existing well # 10 ( Note: Well #10 was also called #8.

JUNE 3, 2014  
 FINAL PROOF MAP OF  
 WATER RIGHTS FOR  
 WELL # 10

FOR  
 WEISHAAR FARMS INCORPORATED

BY  
 BAGETT-GRIFFITH & ASSOCIATES  
 2006 ADAMS AVENUE  
 LA GRANDE, OREGON 97850

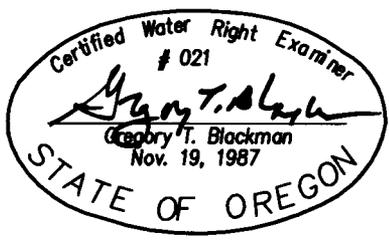

NOTE: The preparation of this map was for the purpose of identifying the location of the proposed water right and has no intent to provide dimensions or location of property ownership lines. Location information shown hereon was furnished by the applicant.

APPLICATION NO. G-14096

PERMIT NUMBER G-12529