


Coos Bay - North Bend  
Water Board  
Service Area

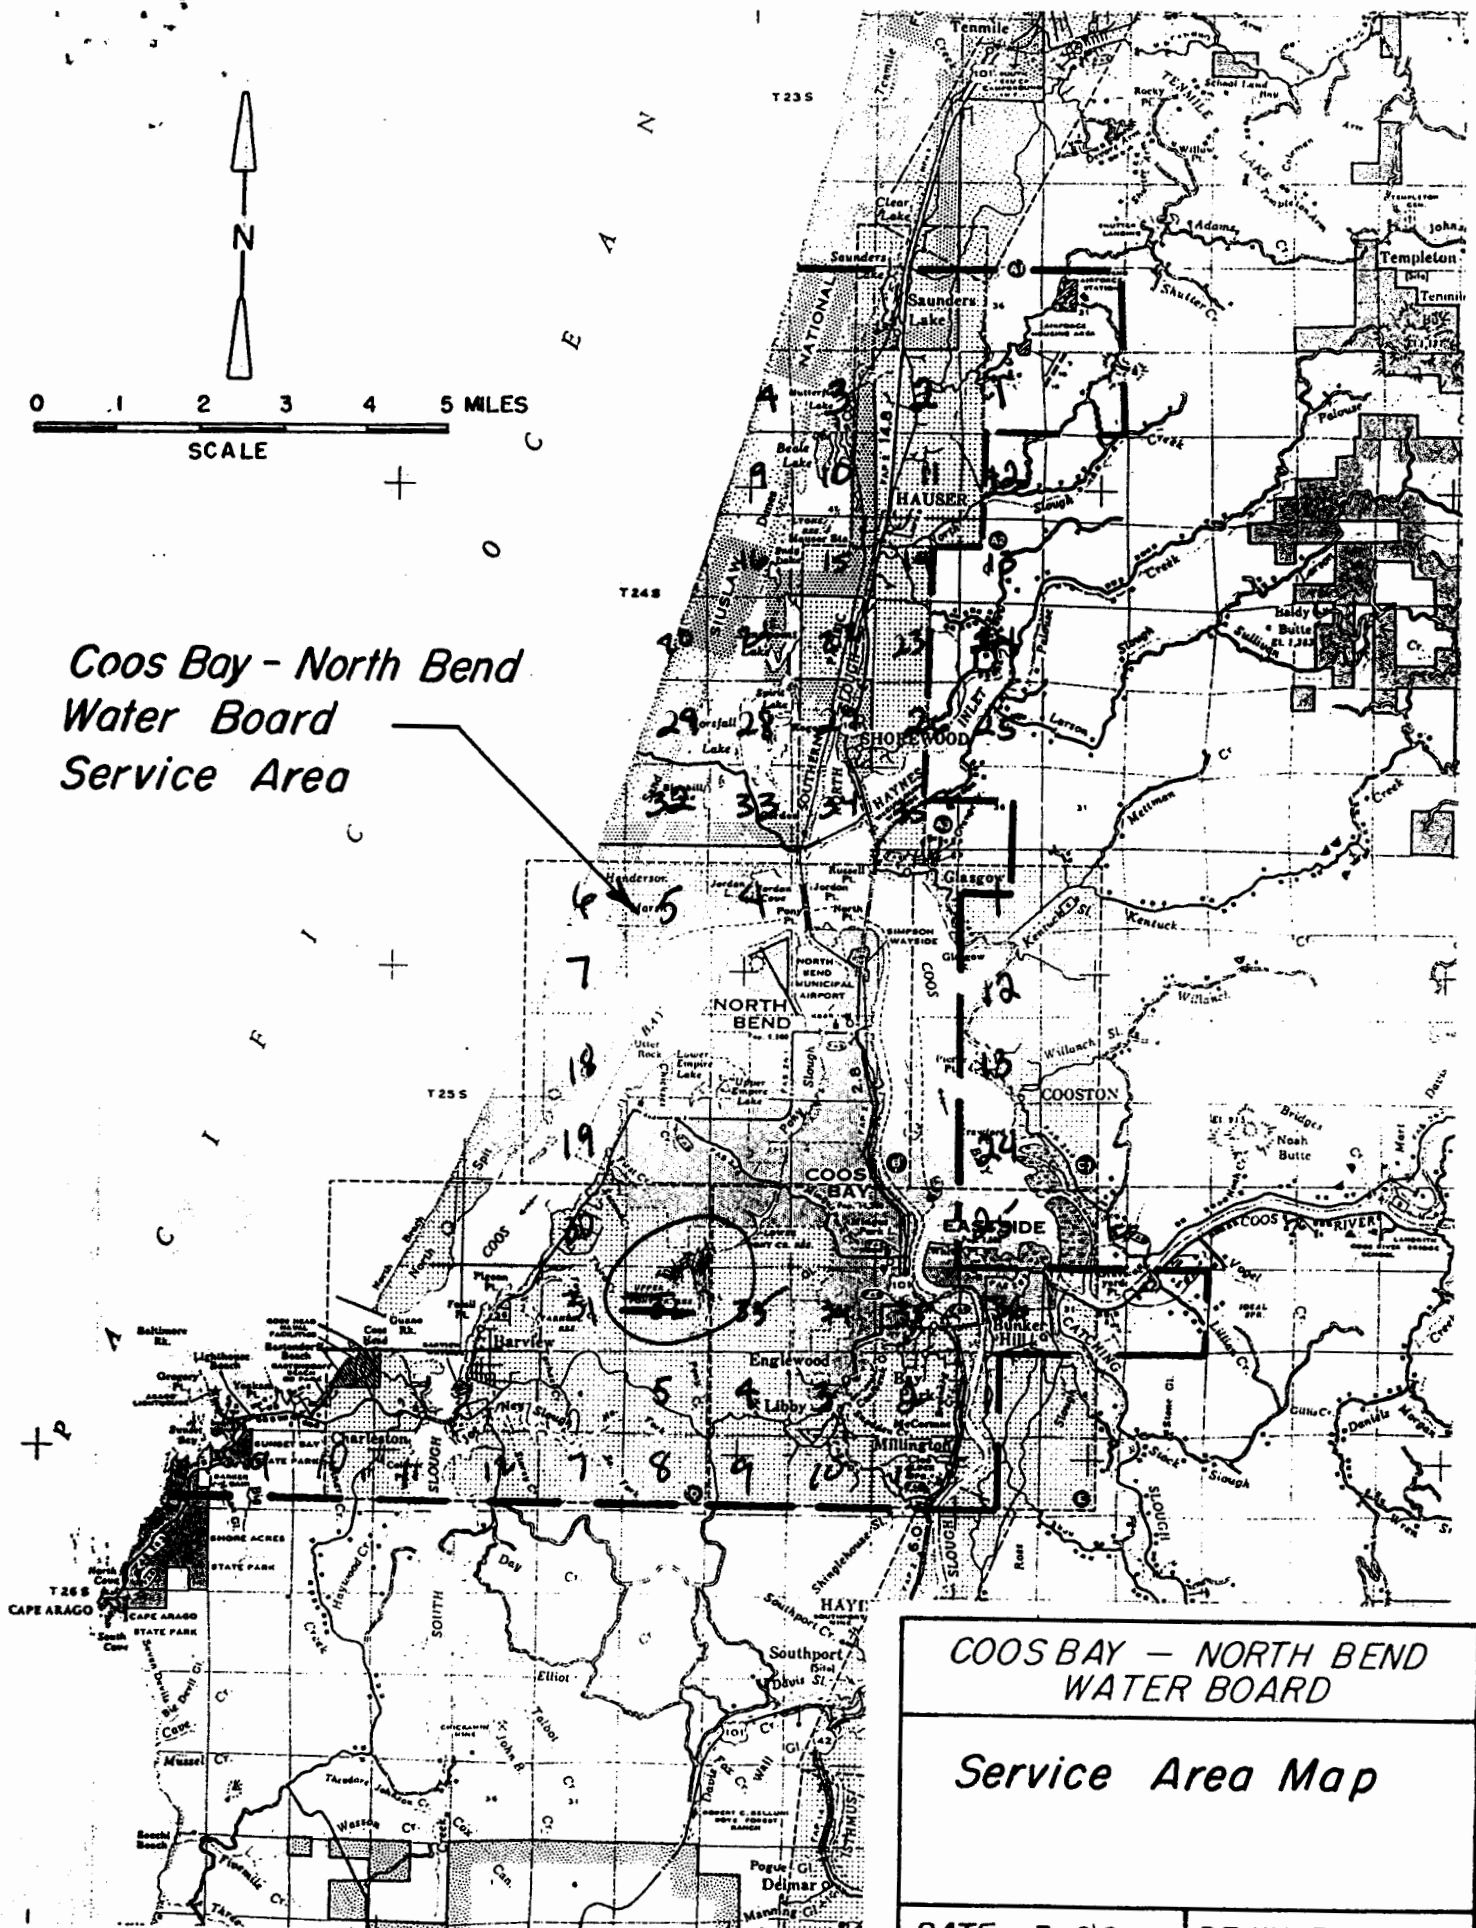

COOS BAY - NORTH BEND  
WATER BOARD


Service Area Map

DATE: 3-92	DRWN BY: cec
SCALE: As Shown	EXHIBIT IV-D-4

R-8518  
R-61527

CHARLESTON QUADRANGLE  
OREGON—COOS CO.  
7.5 MINUTE SERIES (TOPOGRAPHIC)  
SE/4 EMPIRE 15' QUADRANGLE

1170 1/4 IN.  
(NORTH BEND)

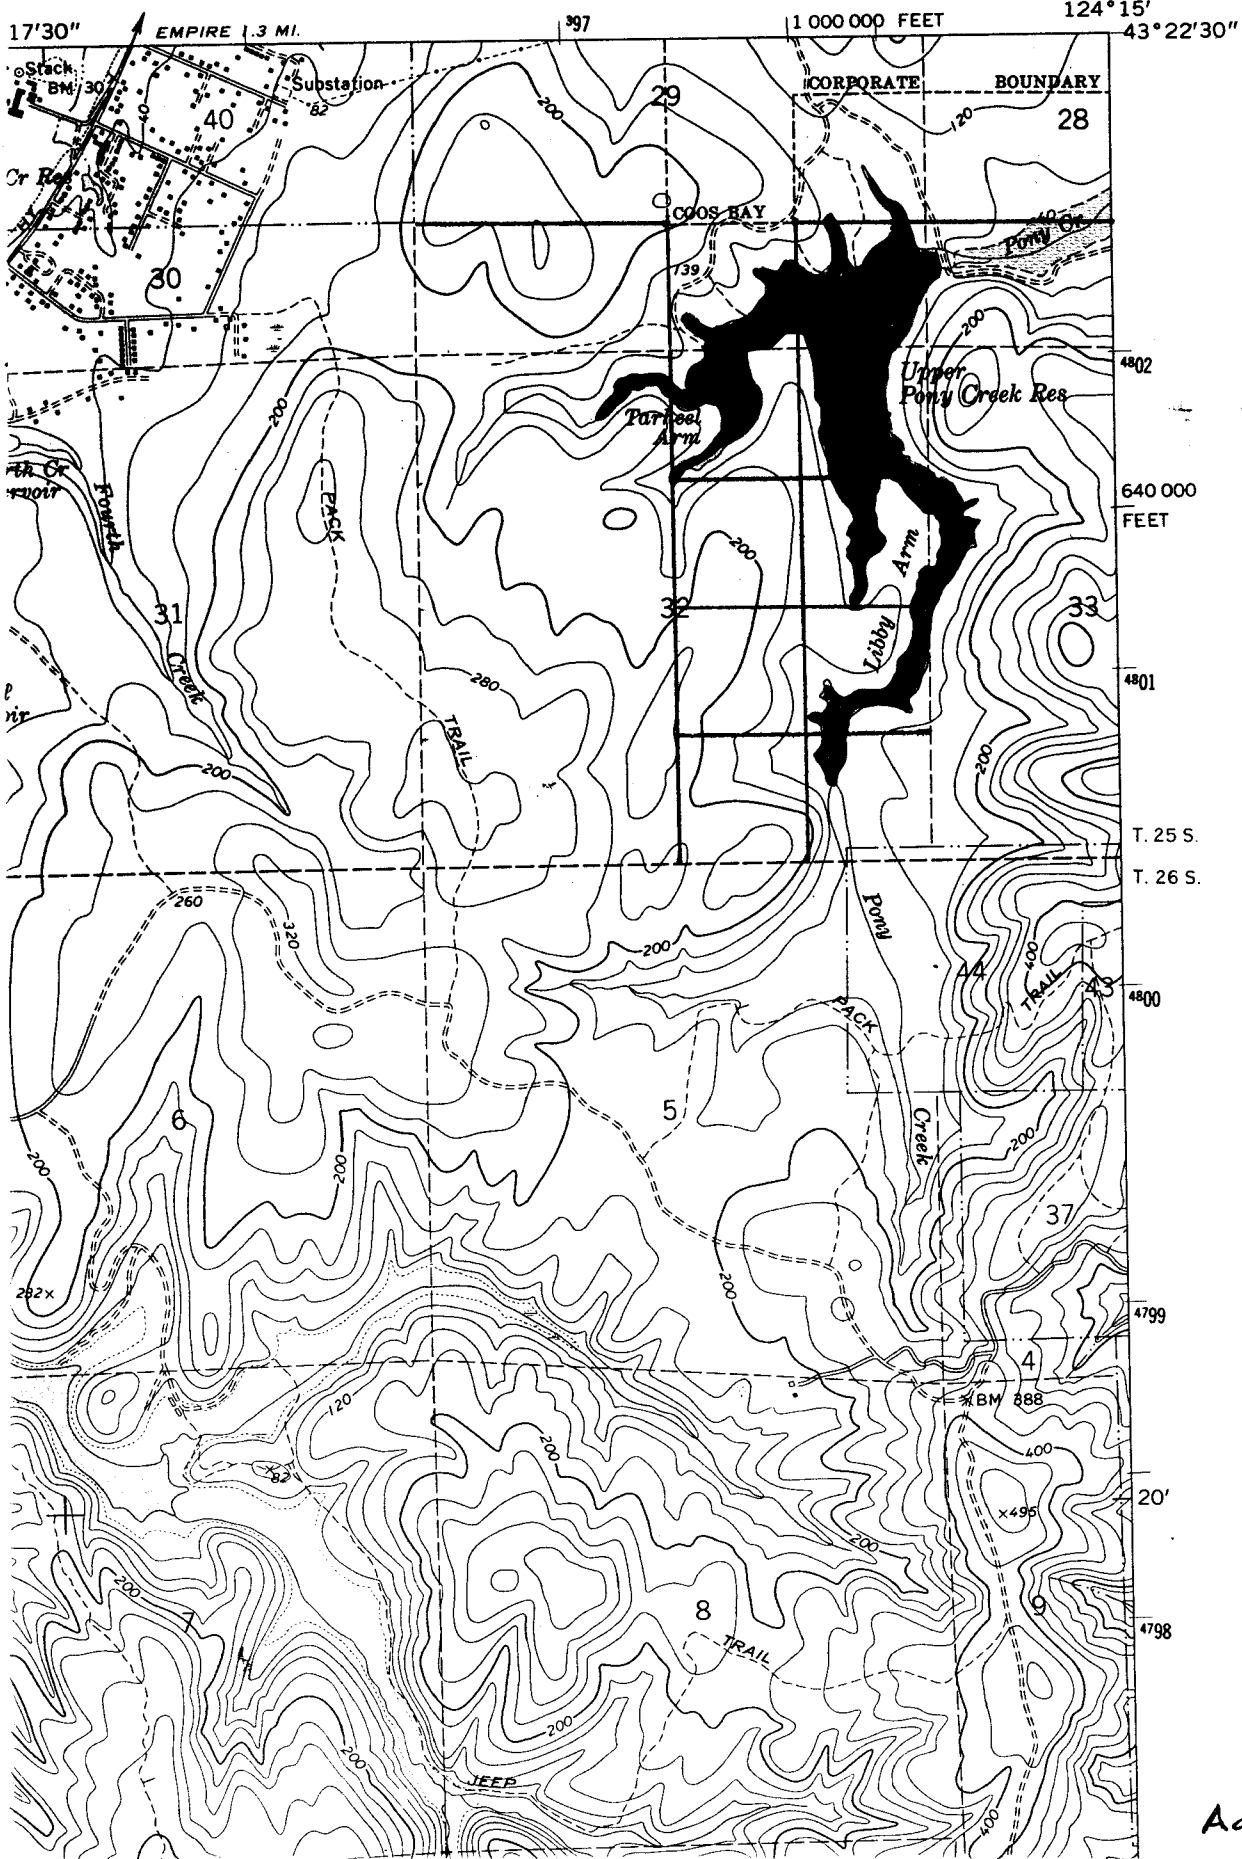

Added to Field Form  
5/20/97 SB