





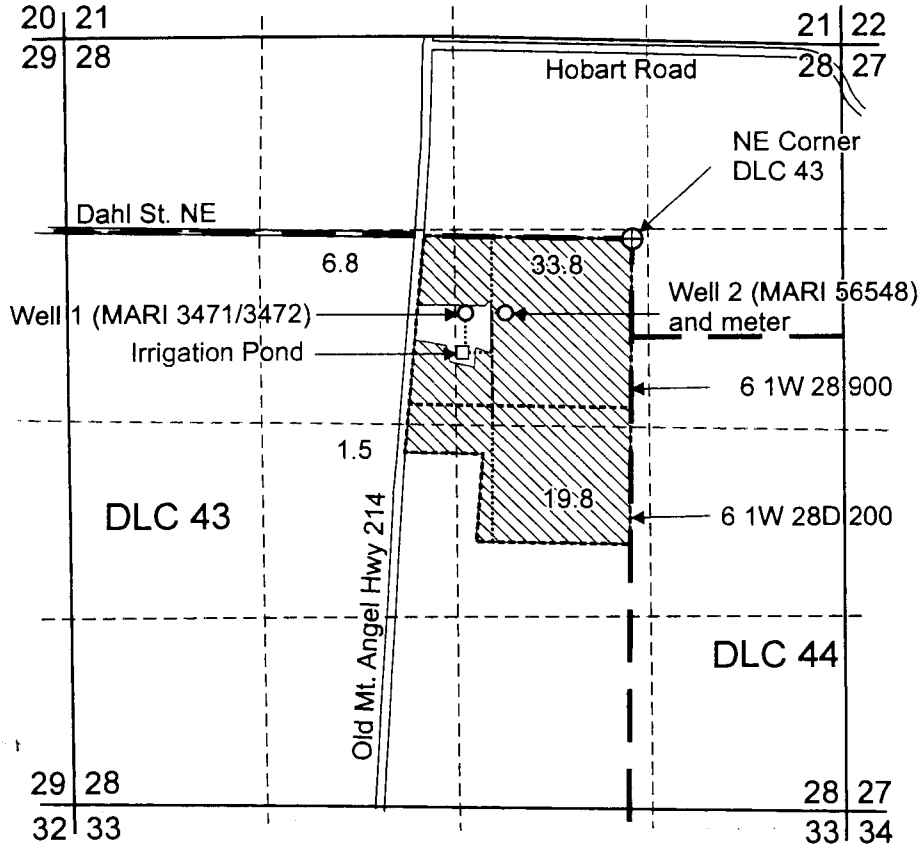


T.6S. R.1W. Sec. 28, W.M.

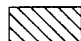

Well 1 (MARI 3471/3472) is located 510 feet south and 1,130 feet west from the northeast corner, DLC 43.


Well 2 (MARI 56548) is located 510 feet south and 860 feet west from the northeast corner, DLC 43.

-  Area (61.9 Acres) irrigated under Transfer 10093
-  4-inch Mainline
-  6-inch Mainline
-  Tax Lot Boundary
-  Donation Land Claim (DLC) Boundary

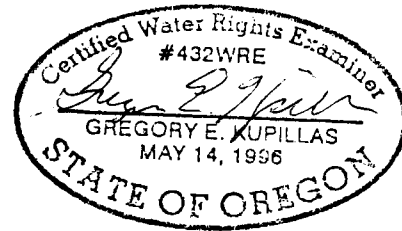

EXPIRATION DATE: 6/30/2015

Scale: 1" = 1,320'

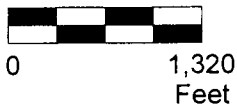

This map was prepared for the purpose of identifying the location of a water right only and is not intended to provide legal dimensions or location of property ownership lines.



Claim of Beneficial Use Map
Transfer 10093

Verl Holden and Florence Hardesty
T.6S. R.1W. Sec. 28, W.M.

Pacific Hydro-Geology Inc.

2014 - bgp