


TOWNSHIP 1 SOUTH, RANGE 3 WEST, W.M.

PORTIONS OF SECTION 16
WASHINGTON COUNTY, OREGON

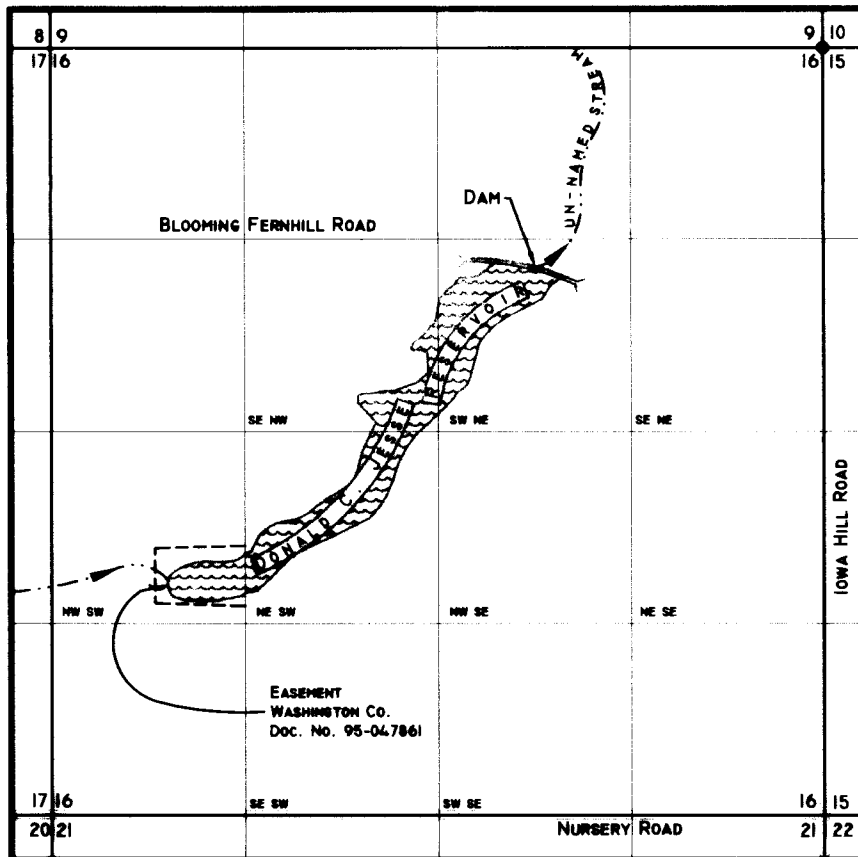

1" = 1320'


THE DAM LOCATED 1,546 FEET SOUTH AND 1,956 FEET WEST OF THE NORTHEAST CORNER OF SECTION 16, T.1S., R.3W., W.M.

FINAL PROOF SURVEY
UNDER
APPLICATION NO. R-83362, PERMIT NO. R-12479
IN THE NAME OF
ALAN M. JESSE
JAMES R. FURBY
MAY 29, 2001

RECEIVED

JUN 25 2001

WATER RESOURCES DEPT.
SALEM, OREGON

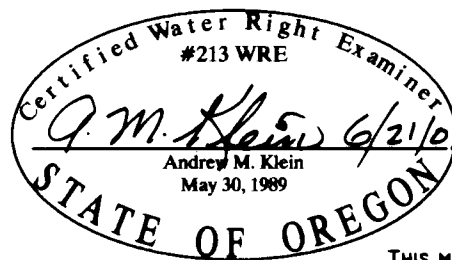

Expires 6/30/2001

THIS MAP WAS PREPARED FOR THE PURPOSE OF IDENTIFYING THE LOCATION OF WATER RIGHT(S) ONLY AND IS NOT INTENDED TO PROVIDE LEGAL DIMENSIONS OR LOCATION OF PROPERTY OWNERSHIP LINES.