


# Claim of Beneficial Use

Permit G-13638, Application G-14768  
A Water Right in the Name of City of Mt. Angel  
Township 6 South, Range 1 West (W.M.)

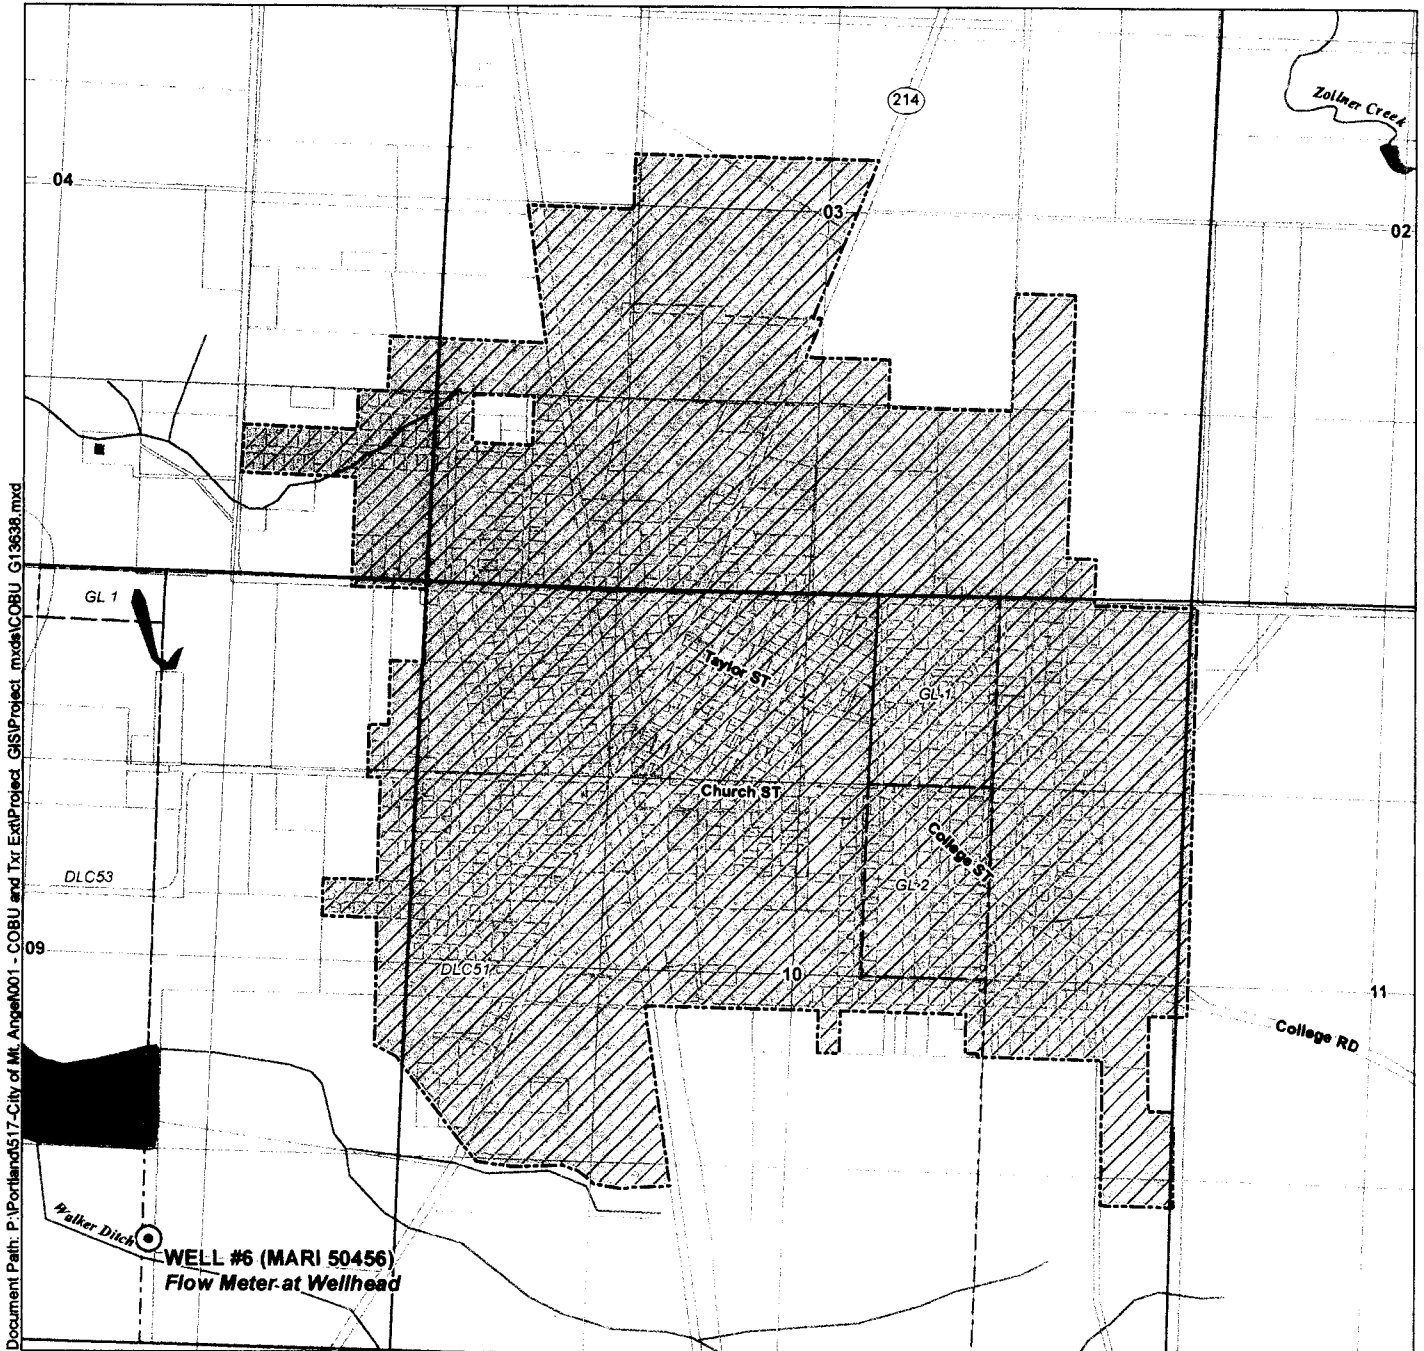

### LEGEND

- Point of Appropriation (POA)
- Place of Use (POU)
- Mt. Angel City Limit
- Donation Land Claim (DLC)
- Government Lot (GL)
- Tax Lot
- Watercourse
- Waterbody

### POU Description

#### Place of Use


The place of use is within the service area of the City of Mt. Angel.

### POA Location Description

#### Point of Appropriation

Located 720 feet North and 1770 feet West from the SE corner of Section 9, Township 6 South, Range 1 West (W.M.)

### Certified Water Rights Examiner Stamp

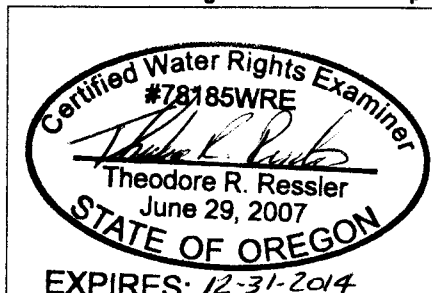

### Disclaimer

This map was prepared for the purpose of identifying the location of a water right only and it is not intended to provide legal dimensions or location of property ownership lines.

### Map Notes

Date: April 9, 2014  
Data Sources: BLM, USGS, Marion Co  
Prepared By: GSI Water Solutions, Inc.

