


# Claim of Beneficial Use

Transfer T-11227 (Permit S-36940, Application S-50771)  
Water Right in the Name of Terra Poma Land, LLC

Township 3 North, Range 27 East (W.M.) Morrow County

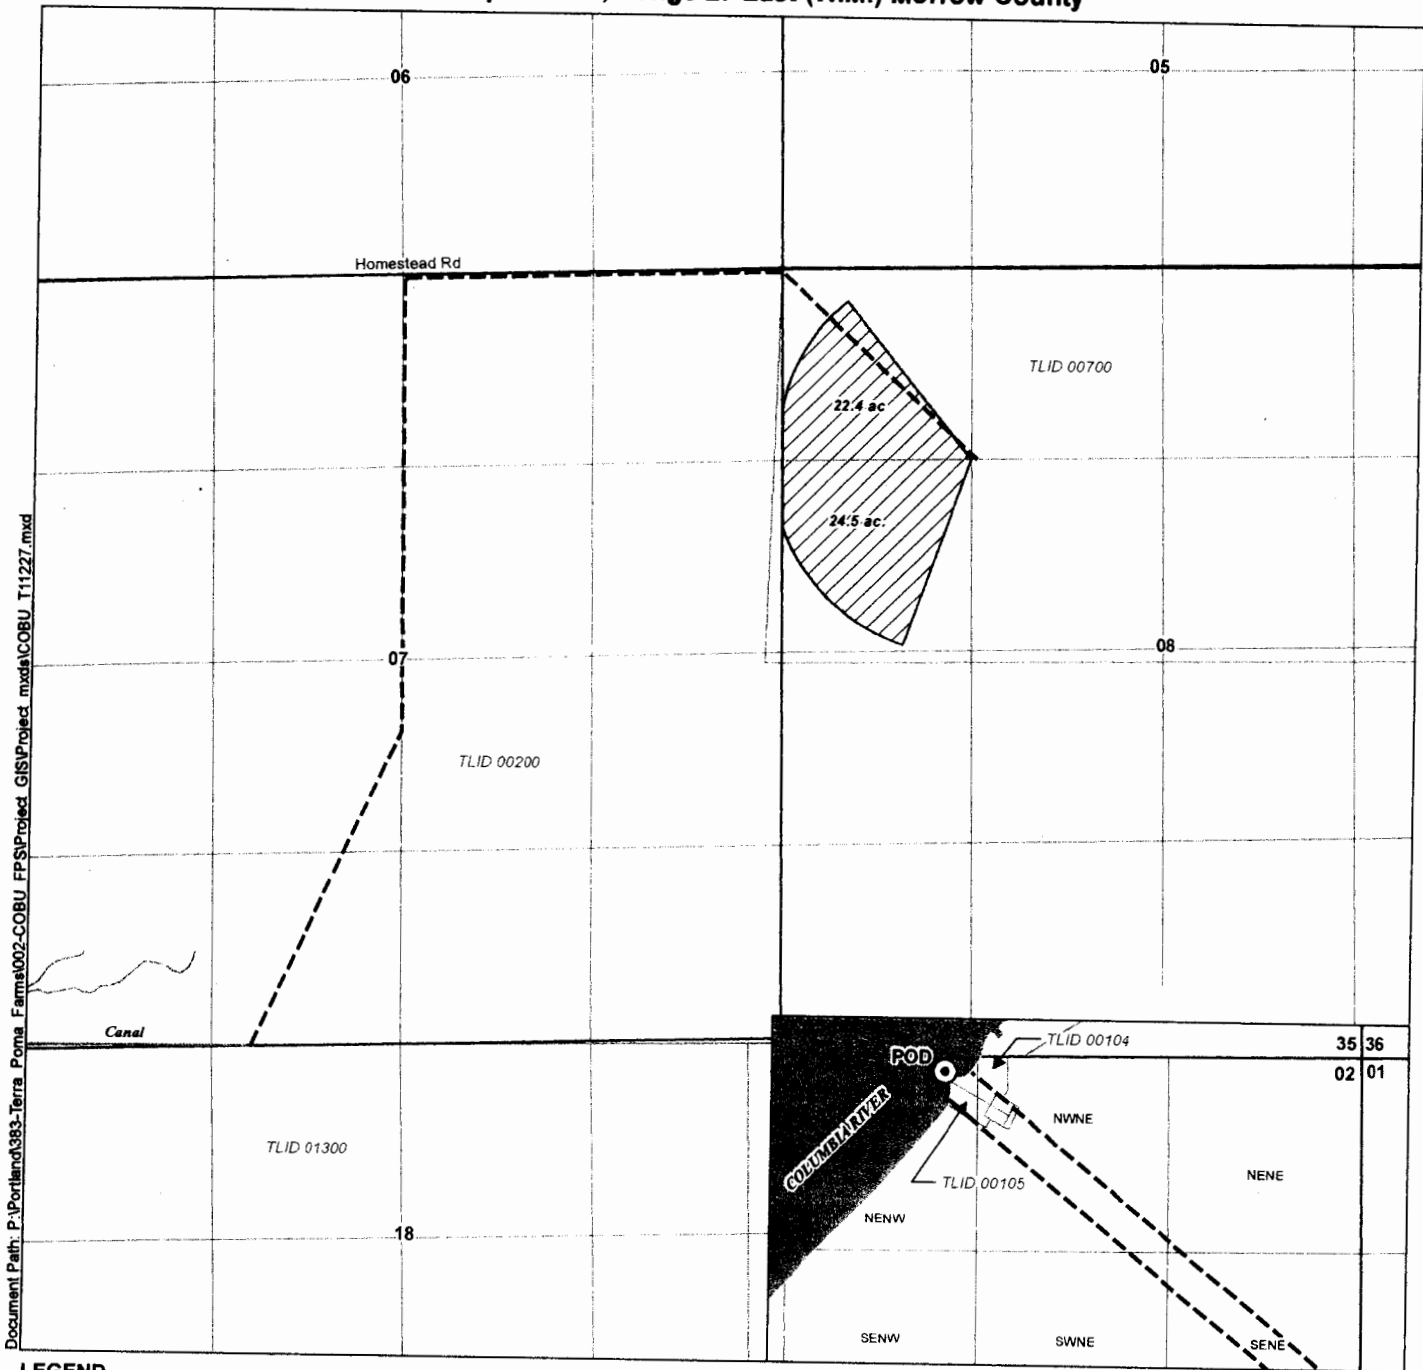


## LEGEND

- Point of Diversion (POD)
- Place of Use (POU)
- Mainline
- Tax Lot
- Major Road
- Watercourse
- Waterbody

**Point of Diversion**  
Located 120 feet South and 2,980 feet West  
from the NE corner of Section 2, Township 4 North,  
Range 25 East, (W.M.)

## Certified Water Rights Examiner Stamp

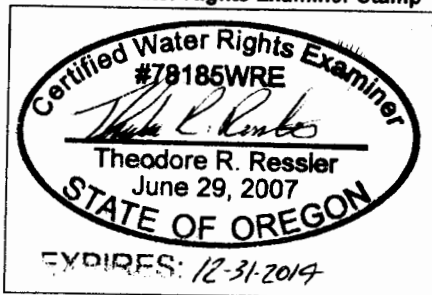

**Disclaimer**  
This map was prepared for the purpose of identifying the  
location of a water right only and it is not intended to provide  
legal dimensions or location of property ownership lines.

**Map Notes**  
Date: September 9, 2014  
Data Sources: ESRI, USGS, BLM  
Prepared By: GSI Water Solutions, Inc.

