


Claim of Beneficial Use

Allocation of Conserved Water CW-68 Water Right in the Name of Terra Poma Land, LLC


Township 3 North, Range 27 East (W.M.) Morrow County

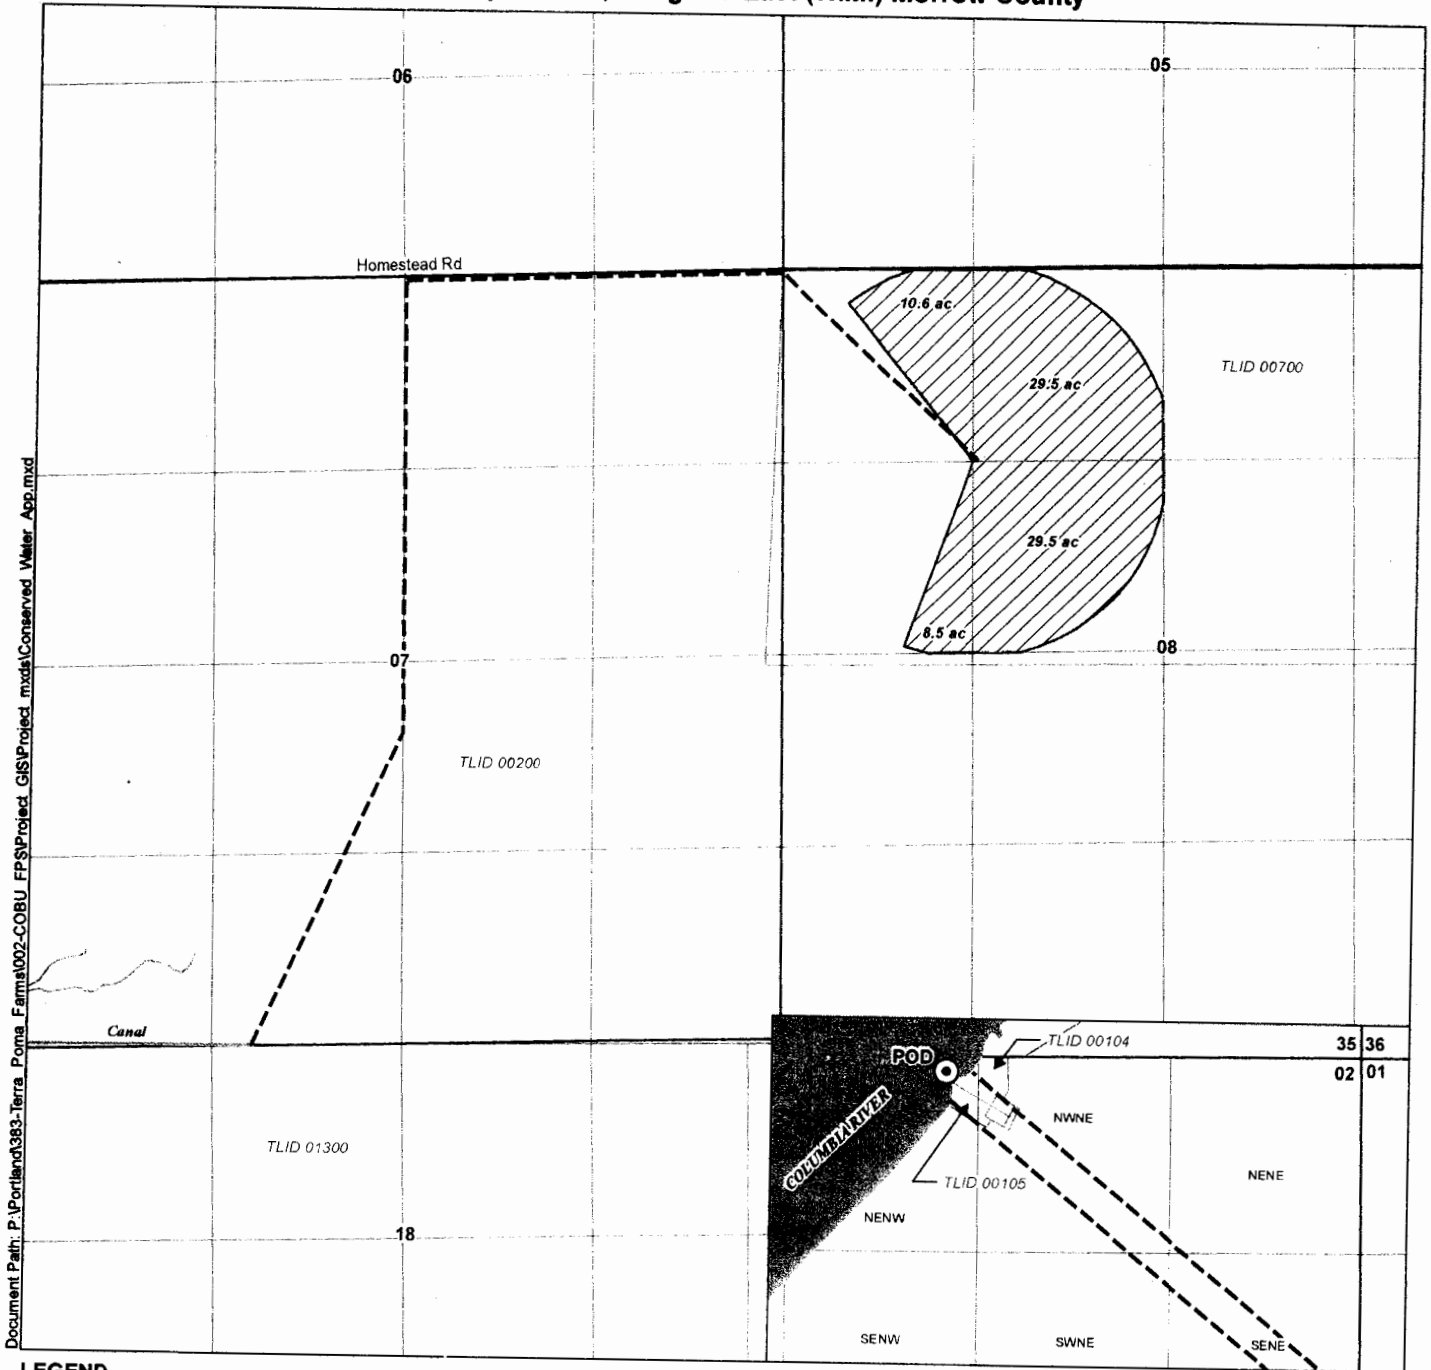

Document Path: P:\Portland\383-Terra Poma Farms\002-COBU_FPSP\Project_GIS\Project_GIS\Conserved_Water_App.mxd

- LEGEND**
- Point of Diversion (POD)
 - Place of Use (POU)
 - Mainline
 - Tax Lot
 - Major Road
 - Watercourse
 - Waterbody

Point of Diversion
Located 120 feet South and 2,980 feet West
from the NE corner of Section 2, Township 4 North,
Range 25 East, (W.M.)

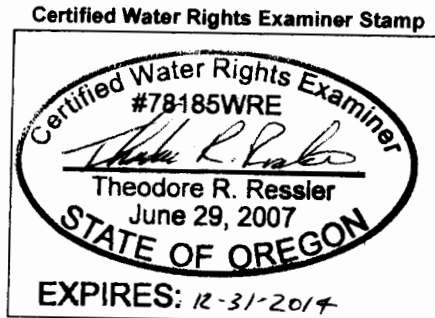

Disclaimer
This map was prepared for the purpose of identifying the location of a water right only and it is not intended to provide legal dimensions or location of property ownership lines.

Map Notes
Date: September 9, 2014
Data Sources: ESRI, USGS, BLM
Prepared By: GSI Water Solutions, Inc.

