

Claim of Beneficial Use Map

RECEIVED BY OWRD

Permit R-14774, Application R-87380

APR 10 2014

Rood Bridge Park, Hillsboro, Oregon
Township 1 South, Range 2 West (W.M.)

SALEM, OR



File Path: P:\Portland\254 - Joint Water Commission\019-Rood Bridge Park WO11_T4\Project_GIS\Project_mxd\COBU_R14774.mxd


LEGEND

- Point of Diversion (POD)
- Place of Use (POU)
- Tax Lot
- Donation Land Claim (DLC)
- Government Lot (GL)
- Watercourse
- Man Made Creek
- Waterbody

POD Location Description

Point of Diversion
Located 250 feet North and 200 feet East from the SW corner of Section 9, Township 1 South, Range 2 West (W.M.)

Certified Water Rights Examiner Stamp

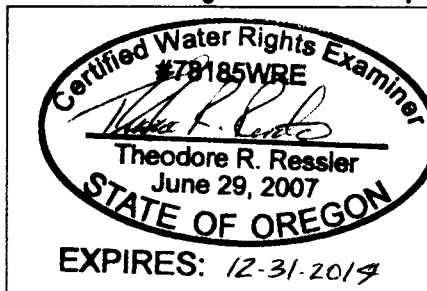

Disclaimer
This map was prepared for the purpose of identifying the location of a water right only and it is not intended to provide legal dimensions or location of property ownership lines.

Map Notes
Date: April 4, 2014
Data Sources: BLM, METRO
Prepared By: GSI Water Solutions, Inc.

