

Claim of Beneficial Use Map

RECEIVED BY OWRD

Permit S-54667, Application S-87381

APR 10 2014

Rood Bridge Park, Hillsboro, Oregon


Township 1 South, Range 2 West (W.M.)

SALEM, OR



- LEGEND**
- Point of Diversion (POD)
 - Place of Use (POU)
 - Flow Meter
 - Pipeline
 - Tax Lot
 - Donation Land Claim (DLC)
 - Government Lot (GL)
 - Watercourse
 - Man Made Creek
 - Waterbody

Certified Water Rights Examiner Stamp

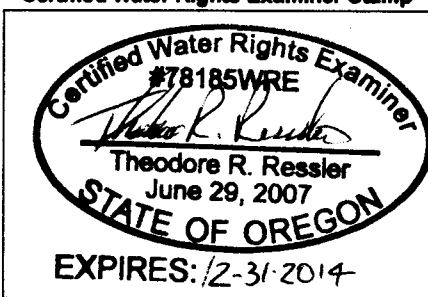

Disclaimer
 This map was prepared for the purpose of identifying the location of a water right only and it is not intended to provide legal dimensions or location of property ownership lines.

Map Notes
 Date: April 4, 2014
 Data Sources: BLM, METRO
 Prepared By: GSI Water Solutions, Inc.

POD Location Description
 Point of Diversion
 Located 240 feet North and 180 feet East from the SW corner of Section 9, Township 1 South, Range 2 West (W.M.)

