

T. 32 S., R. 6 W., W.M.

SCALE: 1" = 400'



PRIMARY - COW CREEK
SUPPL. - GALESVILLE RES.

POINT OF DIVERSION IS 803 FEET SOUTH
AND 124 FEET WEST OF THE EAST-
NORTHEAST CORNER TO DLC NO. 38.

E.N.E. COR.
DLC NO. 38

THE PURPOSE OF THIS MAP IS TO
IDENTIFY THE LOCATION OF THE WATER
RIGHT. IT IS NOT INTENDED TO PROVIDE
INFORMATION RELATIVE TO THE LOCATION
OF PROPERTY OWNERSHIP BOUNDARY
LINES.

SW of the NE

(OLD PACIFIC HWY.)

COW

CREEK

POINT OF DIVERSION

SEC. 35

C1/4

E1/4

5.1 AC.

4.9 AC.

NEW RES.
2.0 A.F.
STOCKWATER

COUNTY ROAD NO. 313

INTERSTATE HWY. NO. 5

NW of the SE



EXP. 12/31/2001

FINAL PROOF SURVEY


UNDER

Application No. S-74309
R-74310

Permit No. 52673
R-11952

IN NAME OF

JOHN L. and PATRICIA L. KING

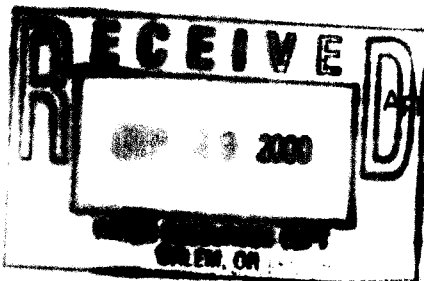

Surveyed; SEPT. 24, 1999

By: R.F. BROWN