


WATER RIGHTS APPLICATION for
PATRICK & JEAN DECATO in the
SE $\frac{1}{4}$, NW $\frac{1}{4}$, SECTION 14
T 40 S, R 14 W, W.M.
Curry County, Oregon

scale: 1" = 400'

February, 1998

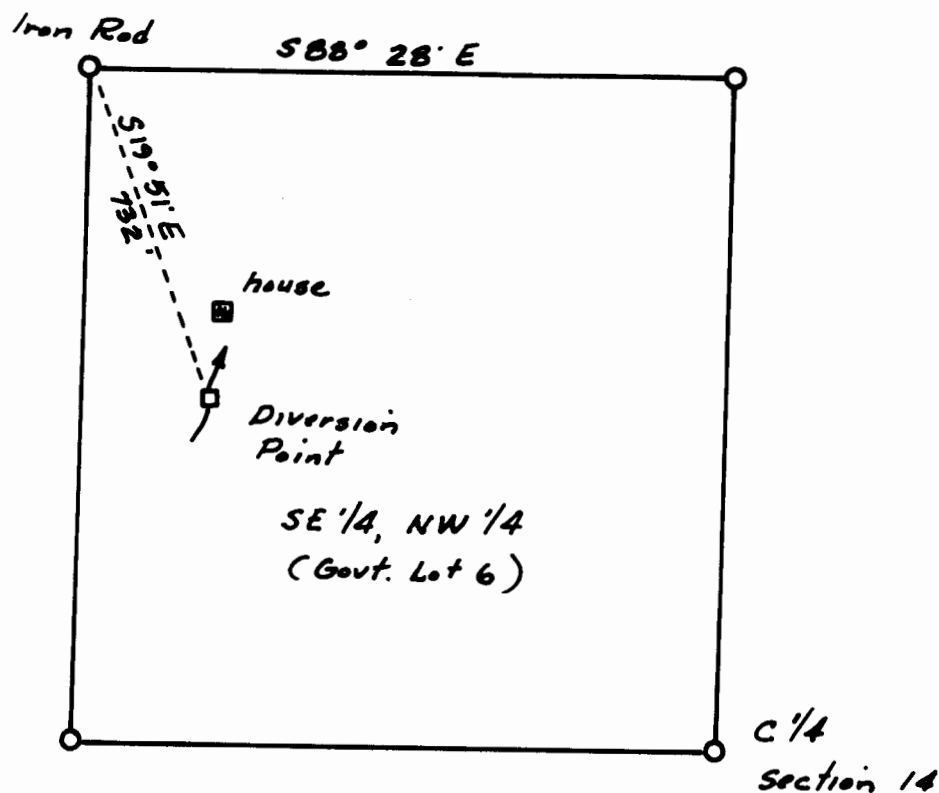

The purpose of this map is to identify the location
of a water right. It is not intended to give information
relative to the location of property ownership lines.

Donald Cormack, CWRE
P.O. Box 1280
Brookings, Oregon

