
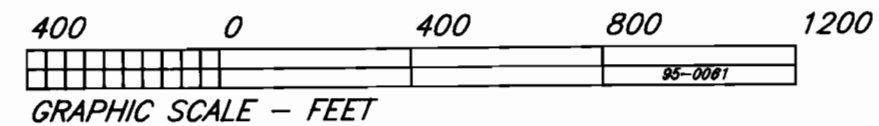


FINAL PROOF SURVEY
 NW 1/4, SEC. 3, T15S, R10E, W.M.,
 DESCHUTES COUNTY, OREGON

APPLICATION NO. G-12347 PERMIT NO. G-11250


IN THE NAME OF
EVERETT AND LORRI MELTON

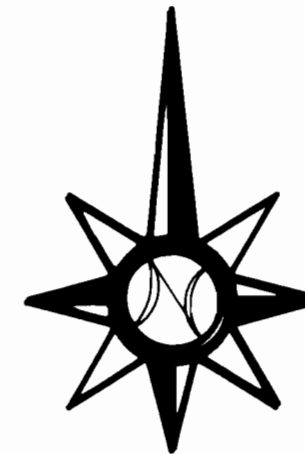

Revised 12-8-95
 12 SEPTEMBER 1995

FRED A. AST, Jr & ASSOCIATES

Land Surveying & Water Rights
 351 W. Cascade St. - P.O. Box 751
 Sisters, Oregon ***** 97759
 Phone: (503) 549 - 7851

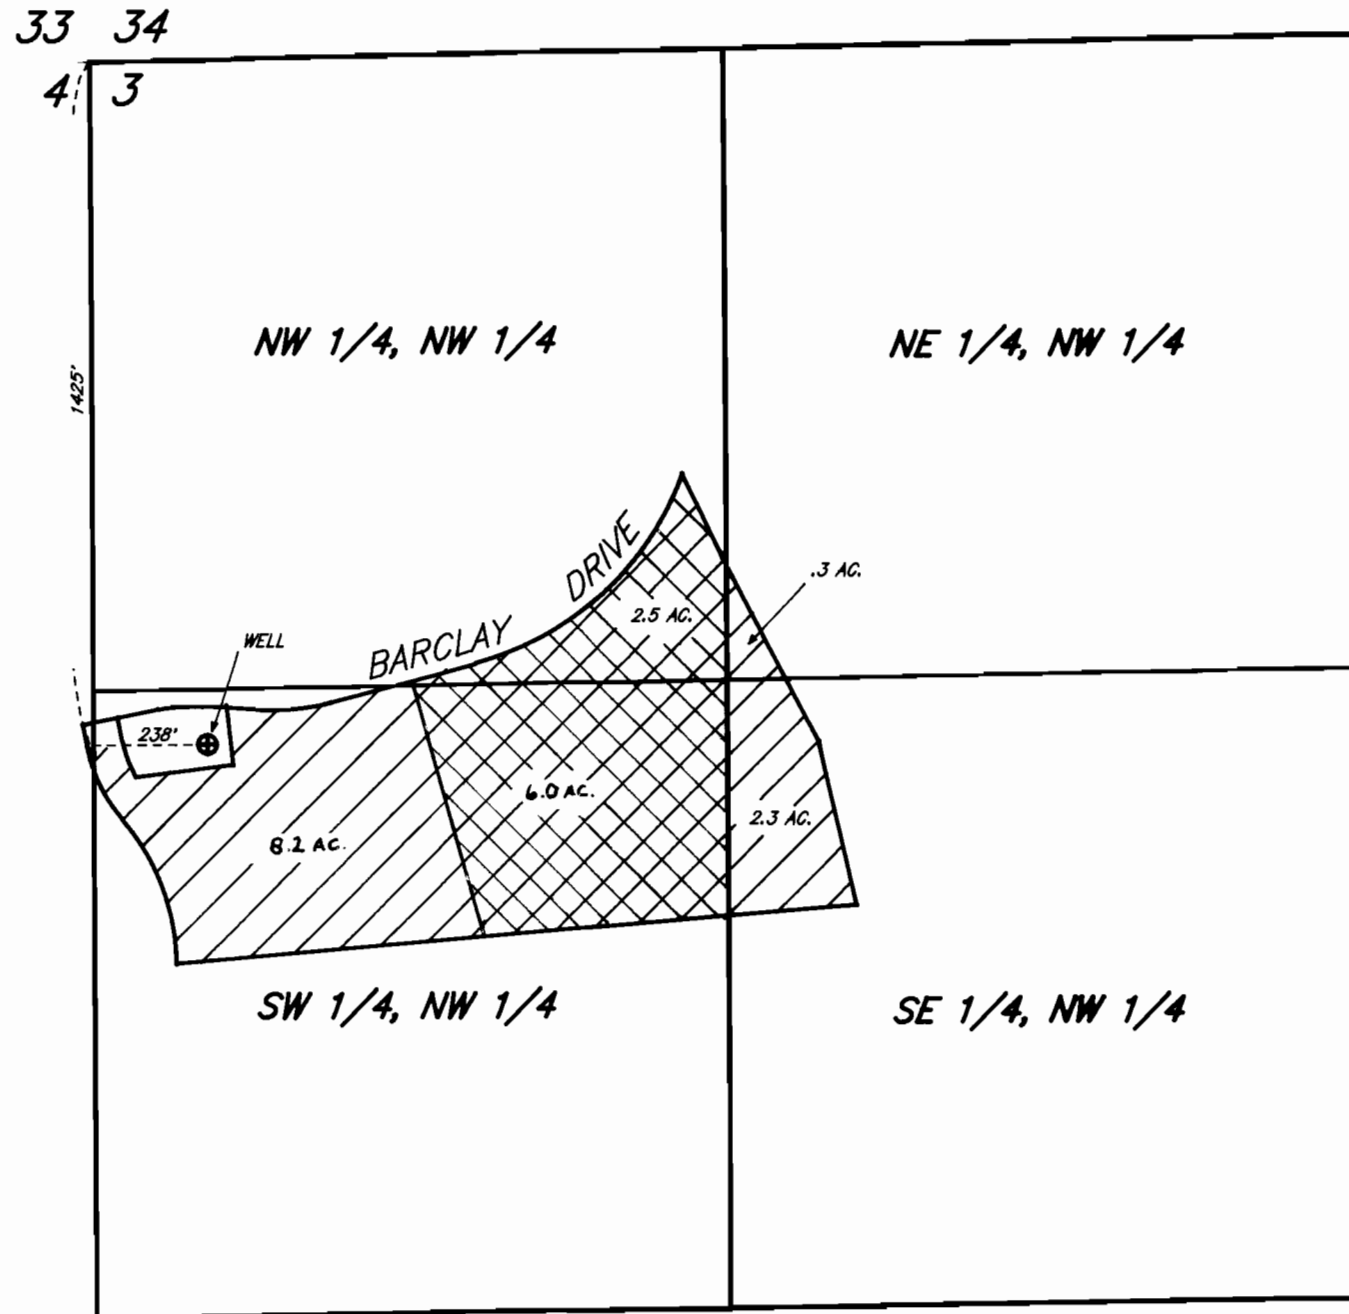

PRIMARY



SUPPLEMENTAL