


Township 3 North, Range 30 East, W.M. Umatilla County, Oregon

Well Located 250' North & 1300' West of East 1/4 Corner of Section 1, SW 1/4, NE 1/4, T. 3 N., R. 30E., W.M.
Lat. N 45°33' 56.23665", Lon. W 118° 48' 08.45765"

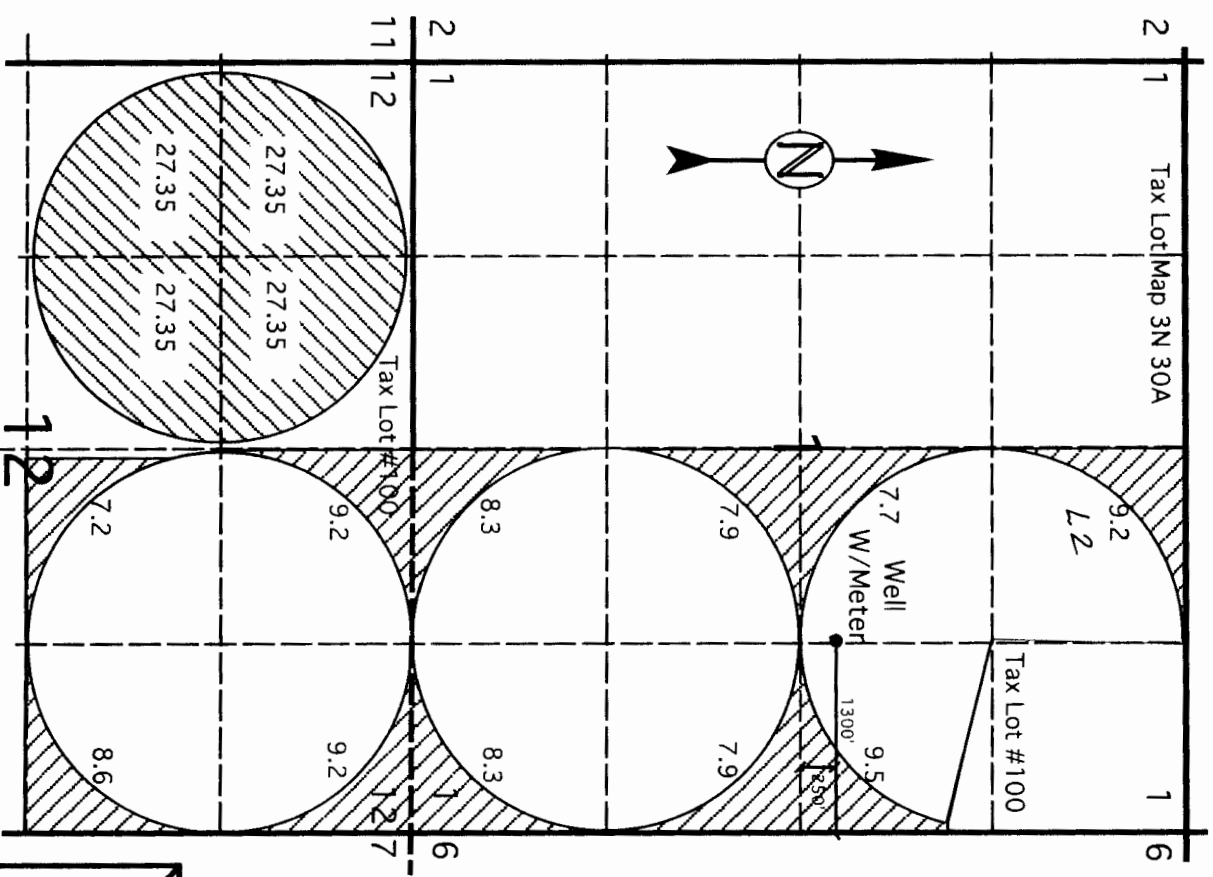

Gov Lot 2 added to Map
by wres / MC 7/24/14

Rev. 04-10-12

-  Permit #G-6932
Transfer #T-10484
At This Location
-  Permit #G-9285
Transfer #T-10484
At This Location

This Map is for the purpose of identifying the location of Water Rights only and is not intended to provide the legal dimensions or locations of property ownership lines.

[Signature]
 R. V. MCKINNIS
 NOV. 29, 1988
 STATE OF OREGON
 Expires 12-31-12

FINAL PROOF MAP
 In Name Of
Thomas E. Branstetter
 SCALE 1" = 1320

ENGINEERING - LAND SURVEYING - WATER RIGHTS

R. V. MCKINNIS ENGINEERING

79980 Prindle Loop Road
 Hermiston, Oregon 97838
 (541) -567-2017

