


TOWNSHIP 16 SOUTH, RANGE 10 EAST, W.M.

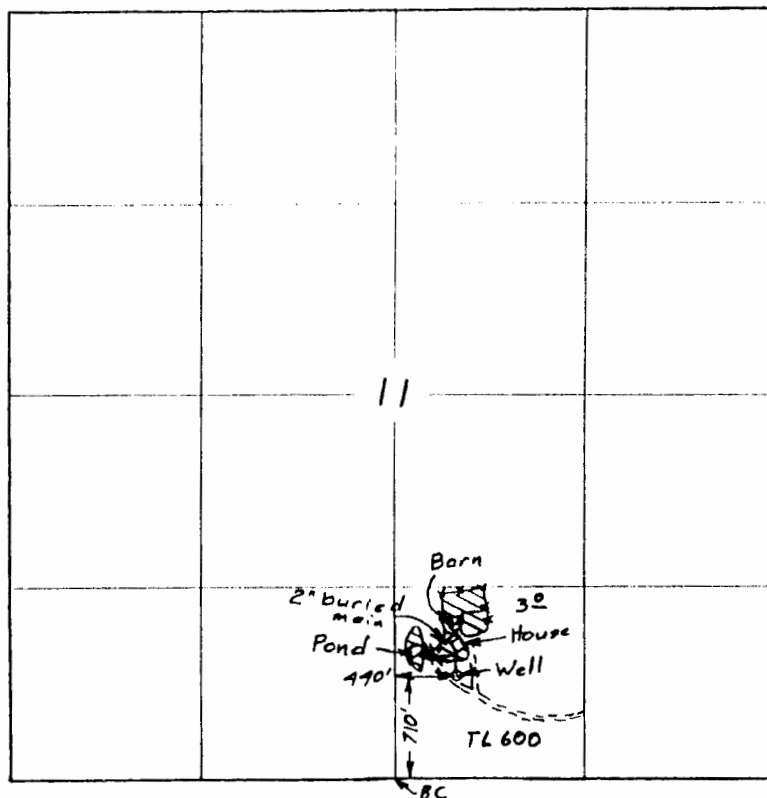

Scale 1" = 1320'




Surveyed August 3, 2001

Claim of Beneficial Use Map
for

GARY & TRUDY BERNE

App G-14724

Per G-13557

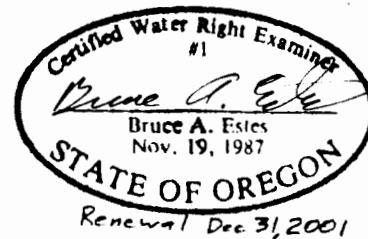

This map is for the purpose of
locating a water right only
and has no intent to provide
legal dimensions or the location
of property lines.

ESTES SURVEYS, LLC

6293 Sunnyview Rd. NE 60382 Arnold Rd.
Salem, OR 97305 Bend, OR 97702
(503) 585-7593 (503) 382-7391