


0 2 5 2

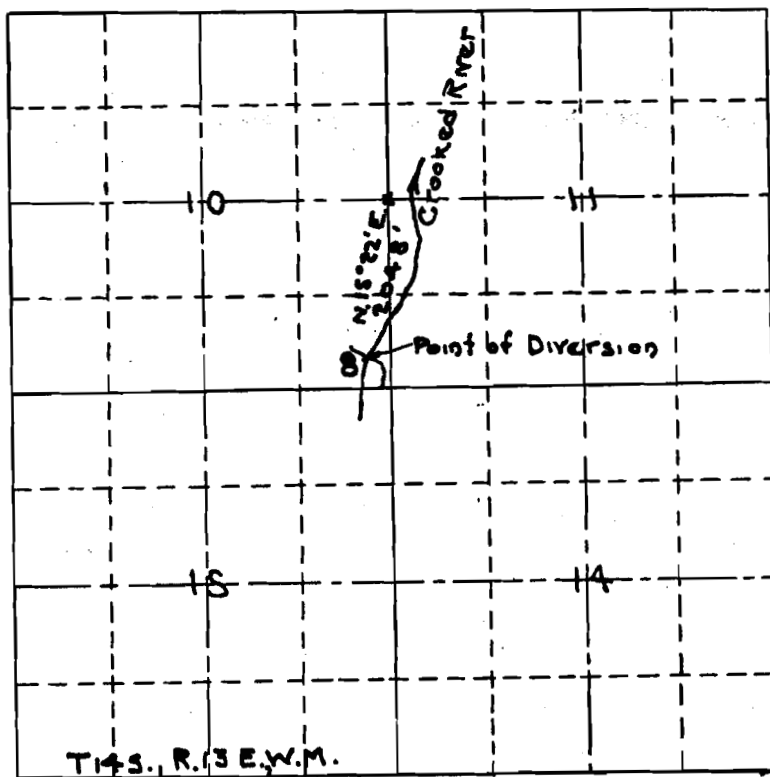

Map
of
S. B. Grant Diversion

OFFICE OF STATE ENGINEER

DEC 4

Application No.
Permit No.

5280
3208

0 2 5 2