


T14S, R11E, W.M.
DESCHUTES CO., OR

SW 1/4, NW 1/4
SECTION 32

GOODRICH ROAD

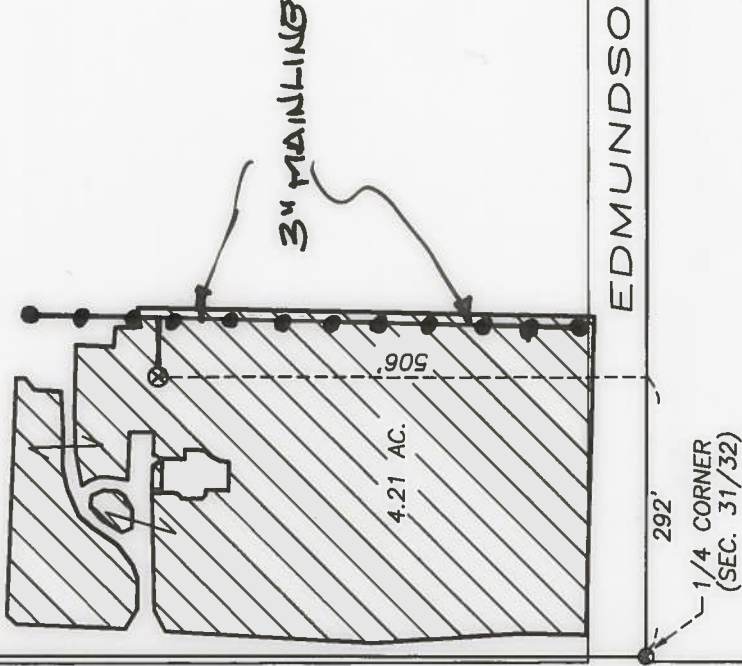

EDMUNDSON ROAD

292'
1/4 CORNER
(SEC. 31/32)

FINAL PROOF SURVEY

APPLICATION G-12827
PERMIT G-12378
TO APPROPRIATE PUBLIC WATERS

A PARCEL OF LAND SITUATED IN THE SW 1/4, NW 1/4,
SECTION 32, T14S, R11E, W.M.,
DESCHUTES COUNTY, OREGON



IRRIGATED AREA

THIS MAP IS FOR THE PURPOSE OF IDENTIFYING THE LOCATION OF THE WATER RIGHT.
IT IS NOT INTENDED TO PROVIDE LEGAL DIMENSIONS OR LOCATIONS OF PROPERTY
OWNERSHIP LINES.

