


T. 30 S., R. 30 E., W.M.

RECEIVED

AUG 30 1989

WATER RESOURCES DEPT.
SALEM, OREGON

DIVERSION IS 520
FEET NORTH AND
1080 FEET EAST
OF THE W 1/4 COR.
OF SECTION 35.

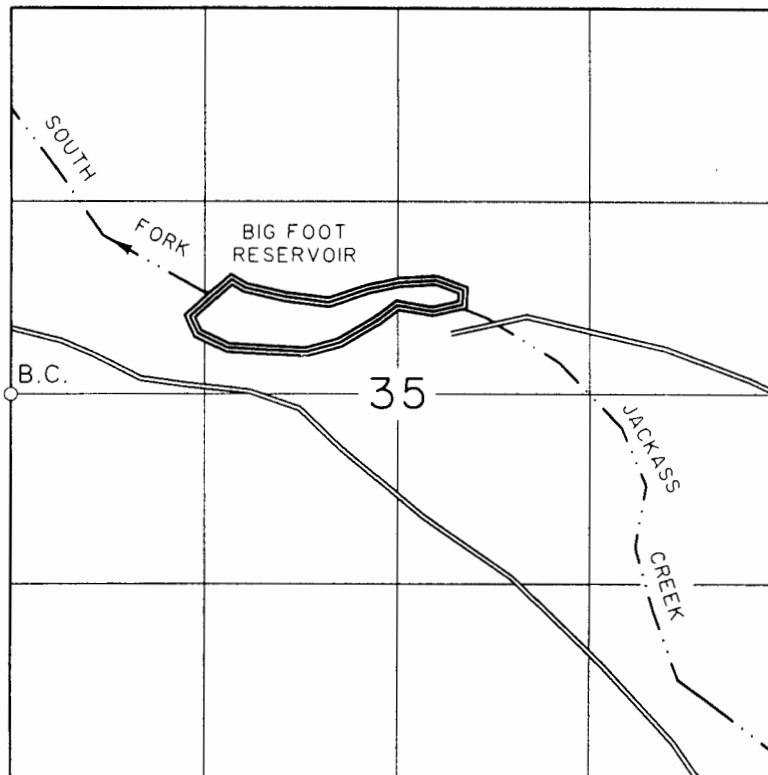

1" = 1320'


CLAIM OF BENEFICIAL USE MAP

IN NAME OF

UNITED STATES BUREAU OF LAND MANAGEMENT

APPLICATION NO. R-56835
S-64772

PERMIT NO. R-12026
52758

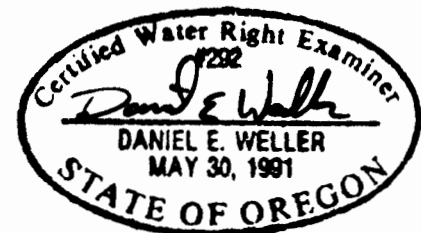

EXPIRES 6/30/00

SURVEYED: JUNE 17, 1999

THE PURPOSE OF THIS MAP IS FOR IDENTIFYING THE LOCATION OF THE WATER RIGHT ONLY AND
IS NOT INTENDED TO PROVIDE LEGAL DIMENSIONS OR LOCATION OF PROPERTY OWNERSHIP LINES

U.S. BUREAU OF LAND MANAGEMENT-OSO
BRANCH OF GEOGRAPHIC SCIENCES

DWG:

EXECUTED BY:
DANIEL E. WELLER, PLS, CWRE
P.O. BOX 2965
PORTLAND, OREGON 97208