


Section 20 & 29, T.4S, R.1W, W.M.

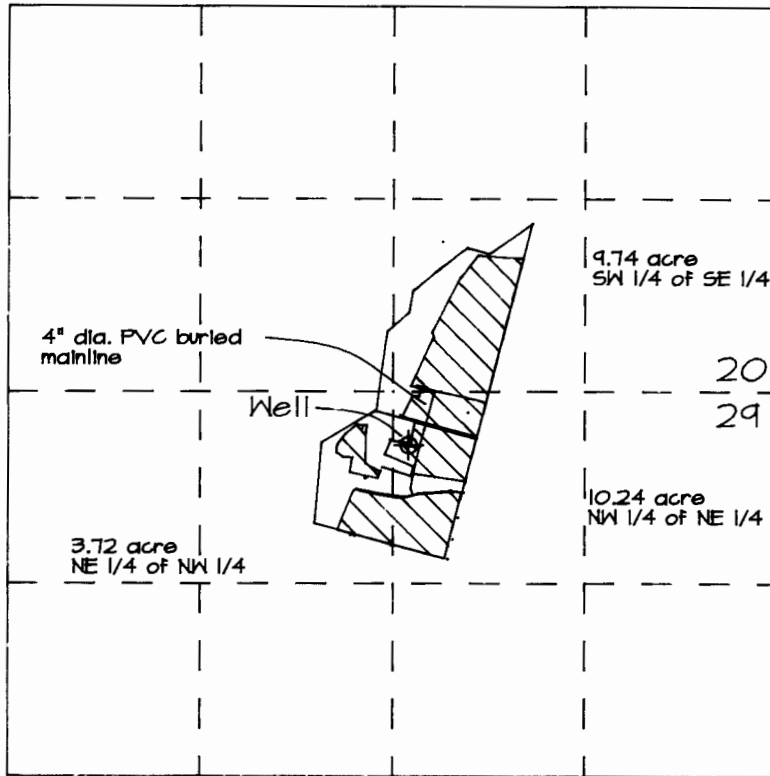

Scale 1" = 1320'

Well is 369 feet south and 2533 feet west of the ~~NE~~ corner of Section 29.
 NE

 Irrigated Area

CLAIM OF BENEFICIAL USE
FOR
ROSE AND GENE PIRELLI

APPLICATION NO. G-13828 PERMIT NO. 12554

THE PREPARATION OF THIS MAP IS FOR THE PURPOSE OF IDENTIFYING THE LOCATION OF THE WATER RIGHT ONLY AND HAS NO INTENT TO PROVIDE DIMENSIONS OR LOCATION OF PROPERTY OWNERSHIP LINES.

Jonathan S. Eymann

Changed referenced corner ^{mt} and