
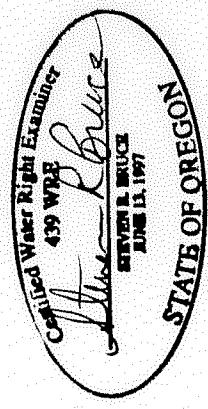
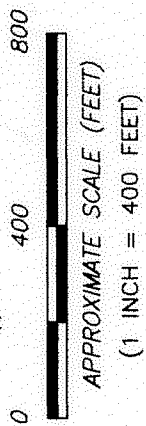


**TOWNSHIP 1 NORTH, RANGE 3 EAST, W.M.  
SECTIONS 28 AND 29**

- LEGEND**
- EXISTING QUARTER SECTION LINES
  - EXISTING SIXTEENTH LINE
  - - - APPROXIMATE PROPERTY BOUNDARY
  - - - LOT LINES
  - 2-INCH-DIAMETER WATER LINE
  - POINT OF APPROPRIATION (WELL)
  - APPROXIMATE MOBILE HOME LOCATION

WELL LOCATED 950' N. AND 20' E. OF SW CORNER OF NW1/4 OF SECTION 28

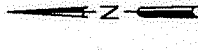

**RECEIVED**

AUG 0 8 2000

WATER RESOURCES DEPT.  
SALEM, OREGON

THIS MAP WAS PREPARED FOR THE PURPOSE OF IDENTIFYING THE LOCATION OF WATER RIGHTS ONLY AND IS NOT INTENDED TO PROVIDE LEGAL DIMENSIONS OR LOCATIONS OF PROPERTY OWNERSHIP LINES.

**SECOR**  
International Incorporated  
015

**CLAIM OF BENEFICIAL USE MAP**  
JOHN M. SIMPSON  
SANDY BOULEVARD MOBILE VILLA  
APPLICATION G-14698, PERMIT G-13464  
JUNE 7 & 8, 2000

FIGURE: **1**

JOB#: 015.08728.500 APPR:

DWN: KPM

DATE: 8/20/00