


T.5S., R.1W., W.M.

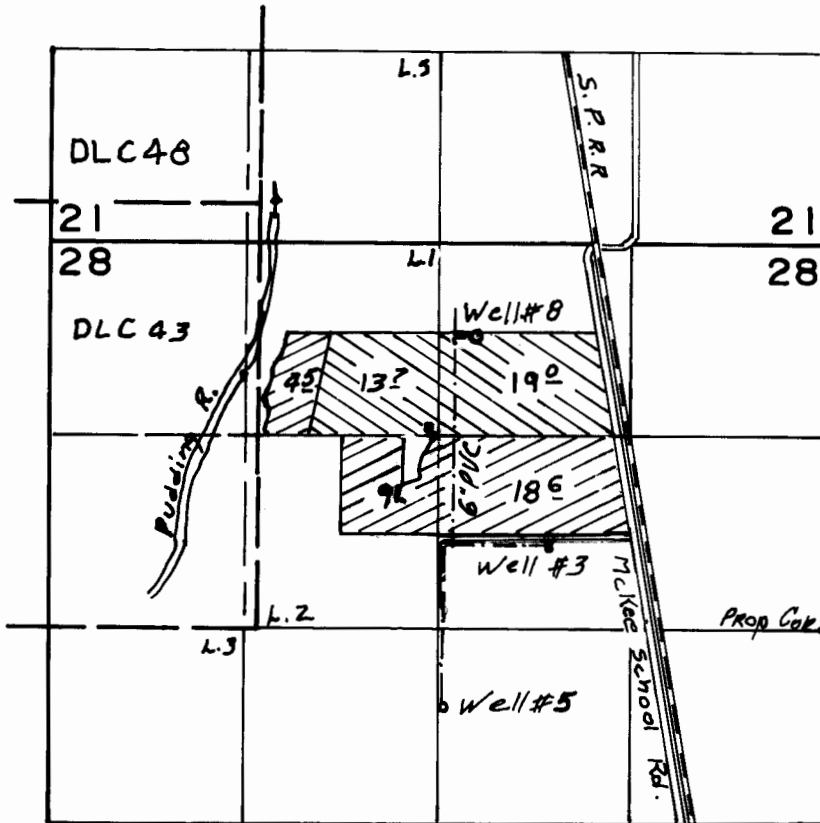

Scale
4" = 1 Mi.

Well #3 loc. 560' N & 1870' W FROM E 1/4 COR. SEC. 28
 Well #5 loc. 500' S & 2400' W FROM " " " "
 Well #8 loc. 2060' N & 2300' W FROM " " " "


Primary Supplemental

FINAL PROOF SURVEY UNDER

Application No. G-13137. Permit No. G-12487...
IN NAME OF

RICHARD FESSLER

Surveyed MAR. 29, 2000, by

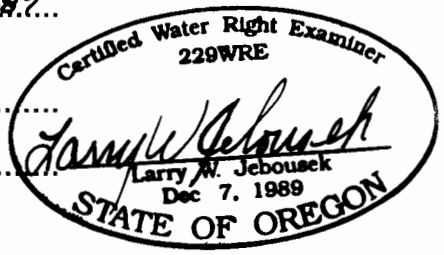

THIS MAP WAS PREPARED FOR THE PURPOSE OF IDENTIFYING THE LOCATION OF A WATER RIGHT ONLY AND IS NOT INTENDED TO PROVIDE LEGAL DIMENSIONS OR LOCATION OF PROPERTY OWNERSHIP LINES.