


FINAL PROOF SURVEY

CLAIM OF BENEFICIAL USE

FOR A PARCEL OF LAND SITUATED IN THE E 1/2 OF
THE NE 1/4 OF THE NE 1/4 OF SEC. 18,
T15S, R10E, W.M., DESCHUTES COUNTY, OREGON



PERMIT G-12757, APPLICATION G-14188
IN THE NAME OF DONA SMITH

TAX LOT 200, MAP 15-10-18

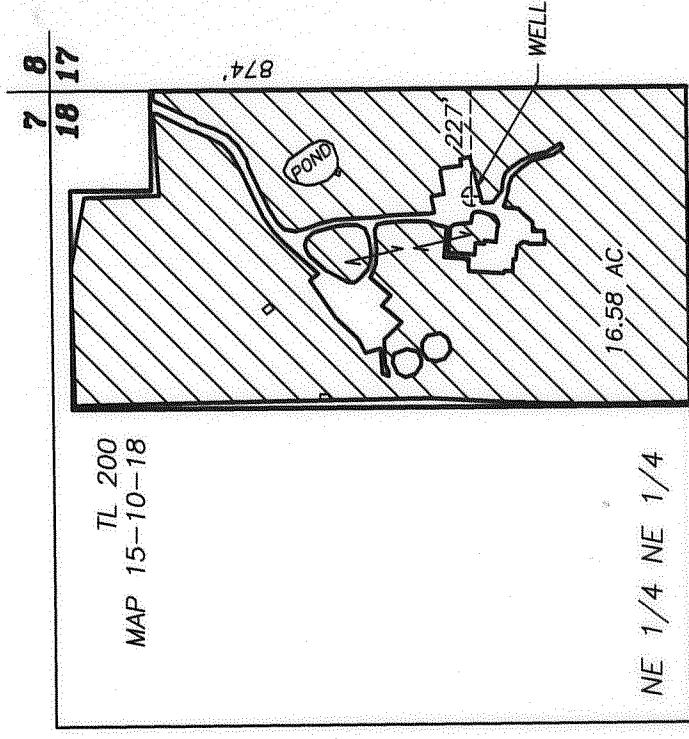

T15S, R10E, W.M.
DESCHUTES CO., OR

9-24-02

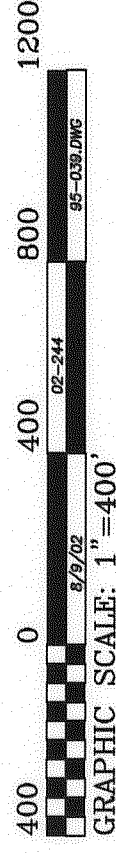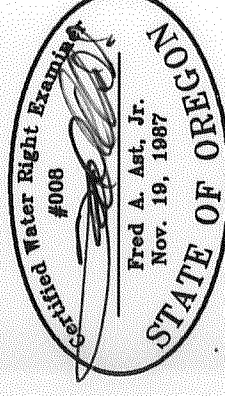

THIS MAP IS FOR THE PURPOSE OF IDENTIFYING THE LOCATION OF THE WATER RIGHT.
IT IS NOT INTENDED TO PROVIDE LEGAL DIMENSIONS OR LOCATIONS OF PROPERTY
OWNERSHIP LINES.

RECEIVED

SEP 26 2002

WATER RESOURCES DEPT.
SALEM, OREGON

Fred A. Ast, Jr. and Associates

250 W. Cascade Avenue

P.O. Box 751

Sisters, Oregon 97759

541-549-7851