


CLAIM OF BENEFICIAL USE


APPLICATION No. G-13394 PERMIT No. G-12512

Section 18, T18S, R46E, WM

TAX LOT No. 18 46B 4800 - MALHEUR COUNTY

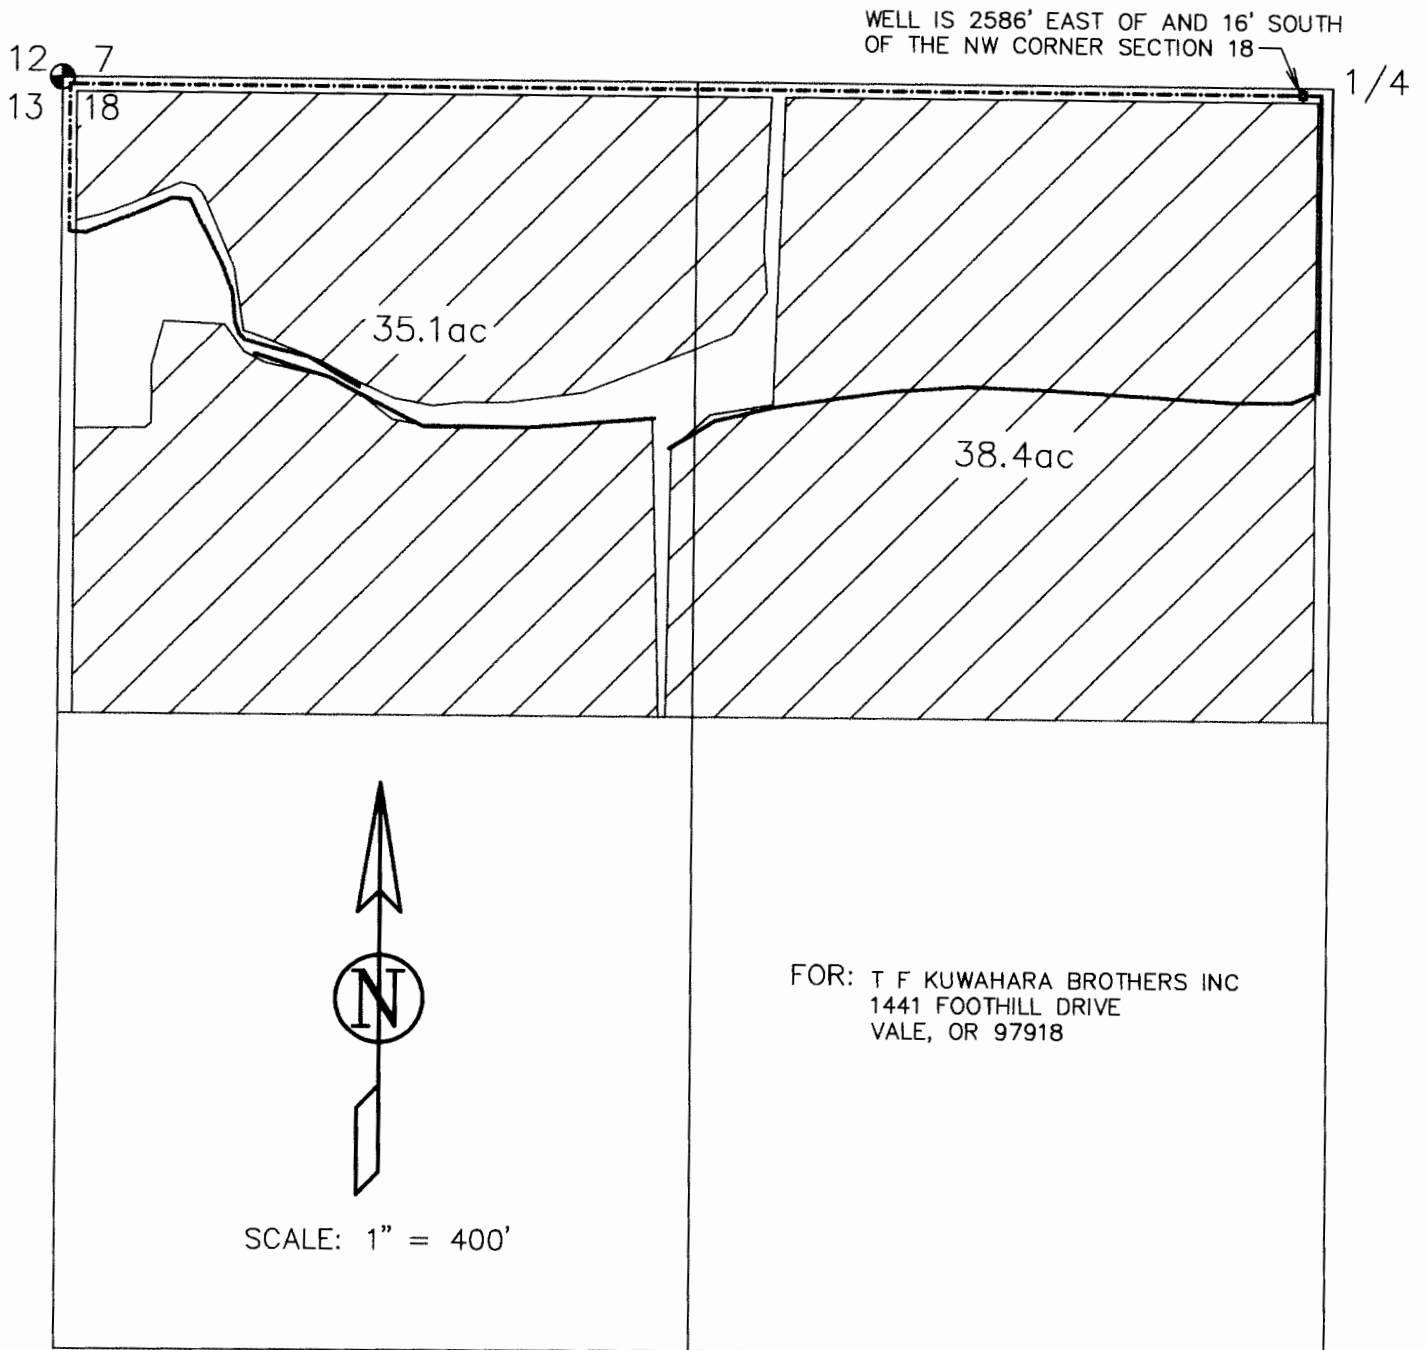

1/4

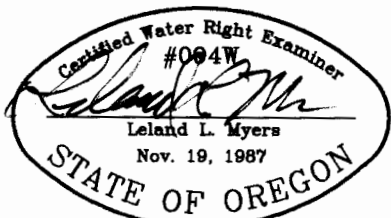

This map is for the purpose of identifying the location of the water right only and has no intent to provide dimensions or location of property ownership lines.