

N


T. 5S., R. 1E., W.M.

SE 1/4 NE 1/4
SEC. 8

SW 1/4 NW 1/4
SEC. 9


T.L. 1600

SCALE: 1" = 400'

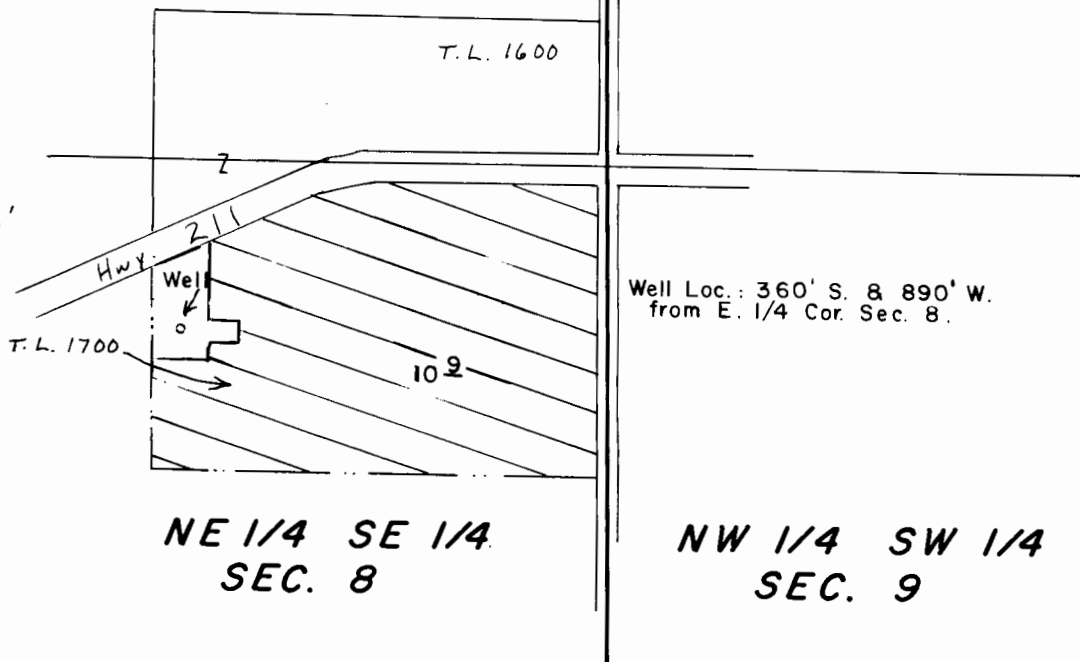

NE 1/4 SE 1/4
SEC. 8

NW 1/4 SW 1/4
SEC. 9

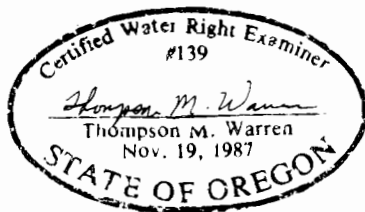

THIS MAP WAS PREPARED SOLELY FOR
THE PURPOSE OF DEPICTING THE LOCATION
OF A WATER RIGHT, AND HAS NO INTENTION
OF BEING USED TO DETERMINE REAL
PROPERTY BOUNDARIES

RECEIVED

SEP 13 1999

WATER RESOURCES DEPT.
SALEM, OREGON

FINAL PROOF SURVEY

UNDER

Application G-12985

Permit G-11958

IN NAME OF

KEITH BANTA

Surveyed 8/20/1999

By T. M. Warren

CHAIN SURVEY