


This map is not intended to provide legal dimensions or locations of property ownership lines.

Final Proof Survey
T125 R6W & 5W, W.M.

RECEIVED BY OWRD


APR 05 2013

SALEM, OR

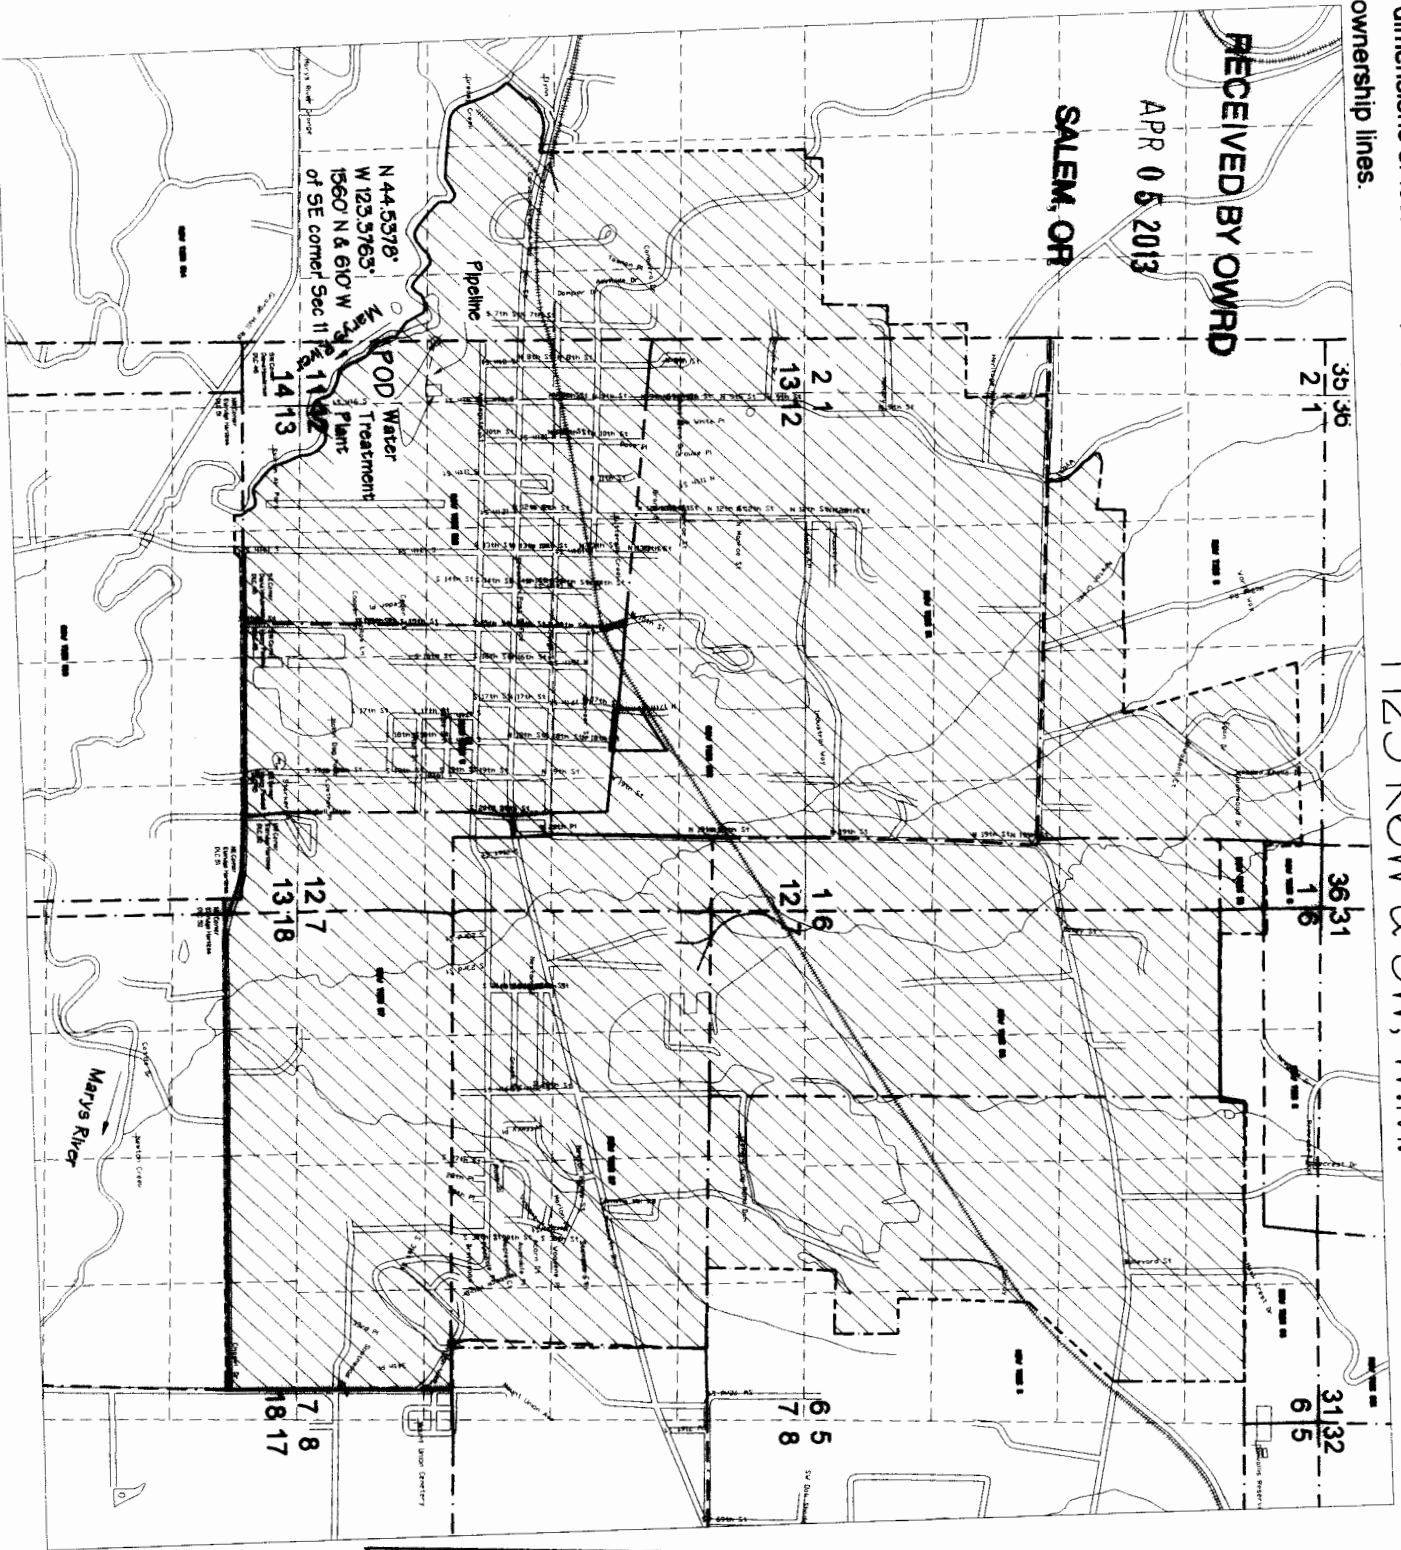

Transfer T - 5623

In the name of
**City of
Philomath**

Transfer To:
Urban Growth
Boundary 

Prepared by
Walter L. Trimmer
OWNER #332
Trimmer Engineering Inc.
3824 NW Westlark Place
Corvallis, OR 97330
541-754-2819

Scale 1" = 2000'
Feb. 28, 2013
Layout: Faxon_WR
File: Philomath_Base.dwg
Based on USGS
Corvallis Quad

DWG 1 of 2

