


TOWNSHIP 10 SOUTH, RANGE 14 EAST, W. M.

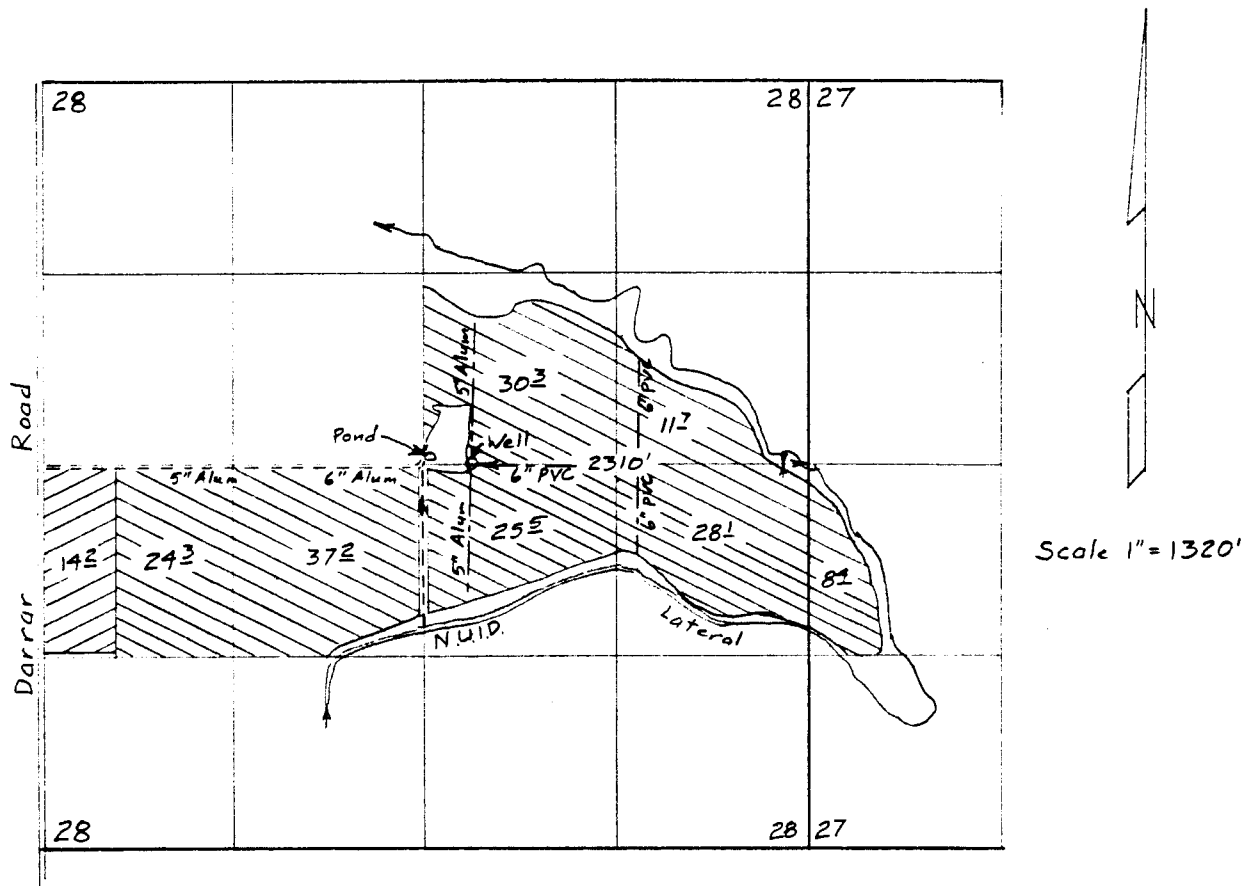

- ⊗ Supp to C-51231 (Deschutes River) 165± acres
- ⊗ Supp to C-51233 (Crooked River) 14± acres


Surveyed September 1, 2000

Claim of Beneficial Use Map  
for

ROBERT L. CROCKER

App. G-12977

Per. G-12495

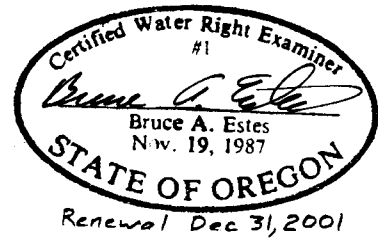

This map is for the purpose of locating a water right only and has no intent to provide legal dimensions or the location of property lines.

**ESTES SURVEYS**

PO Box 17519 60382 Arnold Rd  
Salem, OR 97305-7519 Bend, OR 97702  
(503) 585-7593 (541) 382-7391