

CLAIM OF BENEFICIAL USE SURVEY

Located in Section 17, Township 18 South,
Range 12 East, Willamette Meridian,
Deschutes County, Oregon

Bend Golf & Country Club
Tax Lot 2400


Application No. G-12802
Permit No. G-12789



 = Supplemental Water Rights

I, James R. Tye, Certified Water Right Examiner in the State of Oregon, hereby certify that this water rights survey map was prepared under my direct supervision.

The preparation of this map is for the purpose of identifying the location of the water right only and has no intent to provide dimensions or locations of property ownership lines.

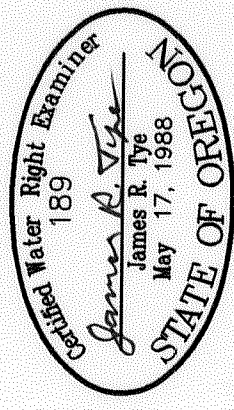

RECEIVED

SEP 28 2000

WATER RESOURCES DEPT.
SALEM, OREGON

W.O.No.: 5213-22

Date: 9-26-00

Scale: 1"=400'

Updated ac to 20.2 in NWSE 18/9-23-04

SUN COUNTRY ENGINEERING & SURVEYING, INC. 920 S.E. ARMOUR RD. BEND, OREGON 97702 PHONE (541) 382-8882

