


CLAIM OF BENEFICIAL USE

APPLICATION No.: G-13468


PERMIT No.: G-12548

EXISTING PRIMARY PER CERT. No. 24707.

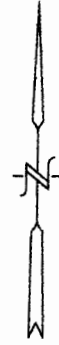

SCALE: 1" = 1320'

T18S, R46E, WM

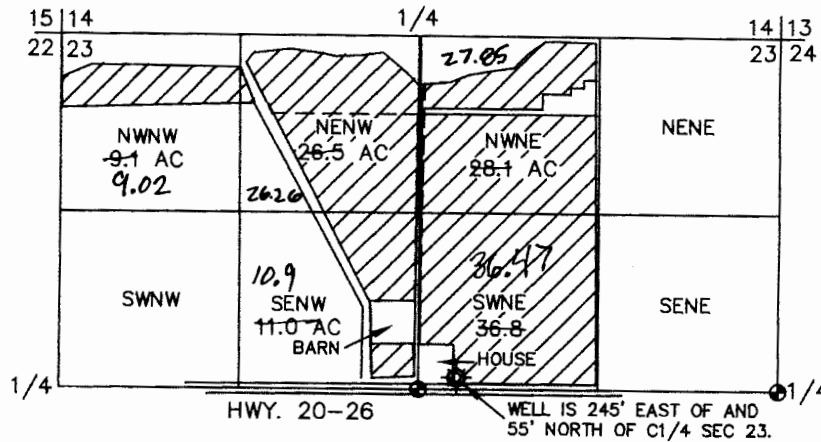


LEGEND


GOVERNMENT CORNER
WELL




CONC. LINED DITCH
IRRIG. PIPE

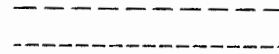

SUPPLEMENTAL RIGHT

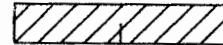

This map is for the purpose of identifying the location of the water right only and has no intent to provide dimensions or location of property ownership lines.

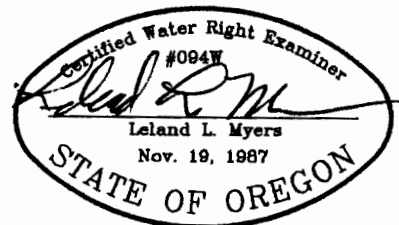

RECEIVED

JUN 29 2000

WATER RESOURCES DEPT.
SALEM, OREGON

Acreages Updated by WRD DC 12/15/14