


FINAL PROOF SURVEY

APPLICATION NO. G-13874
PERMIT NO. G-12810

IN THE NAME OF: PHIL VAN HISE

SECTION 29, T.1 S., R.4 E., W.M.

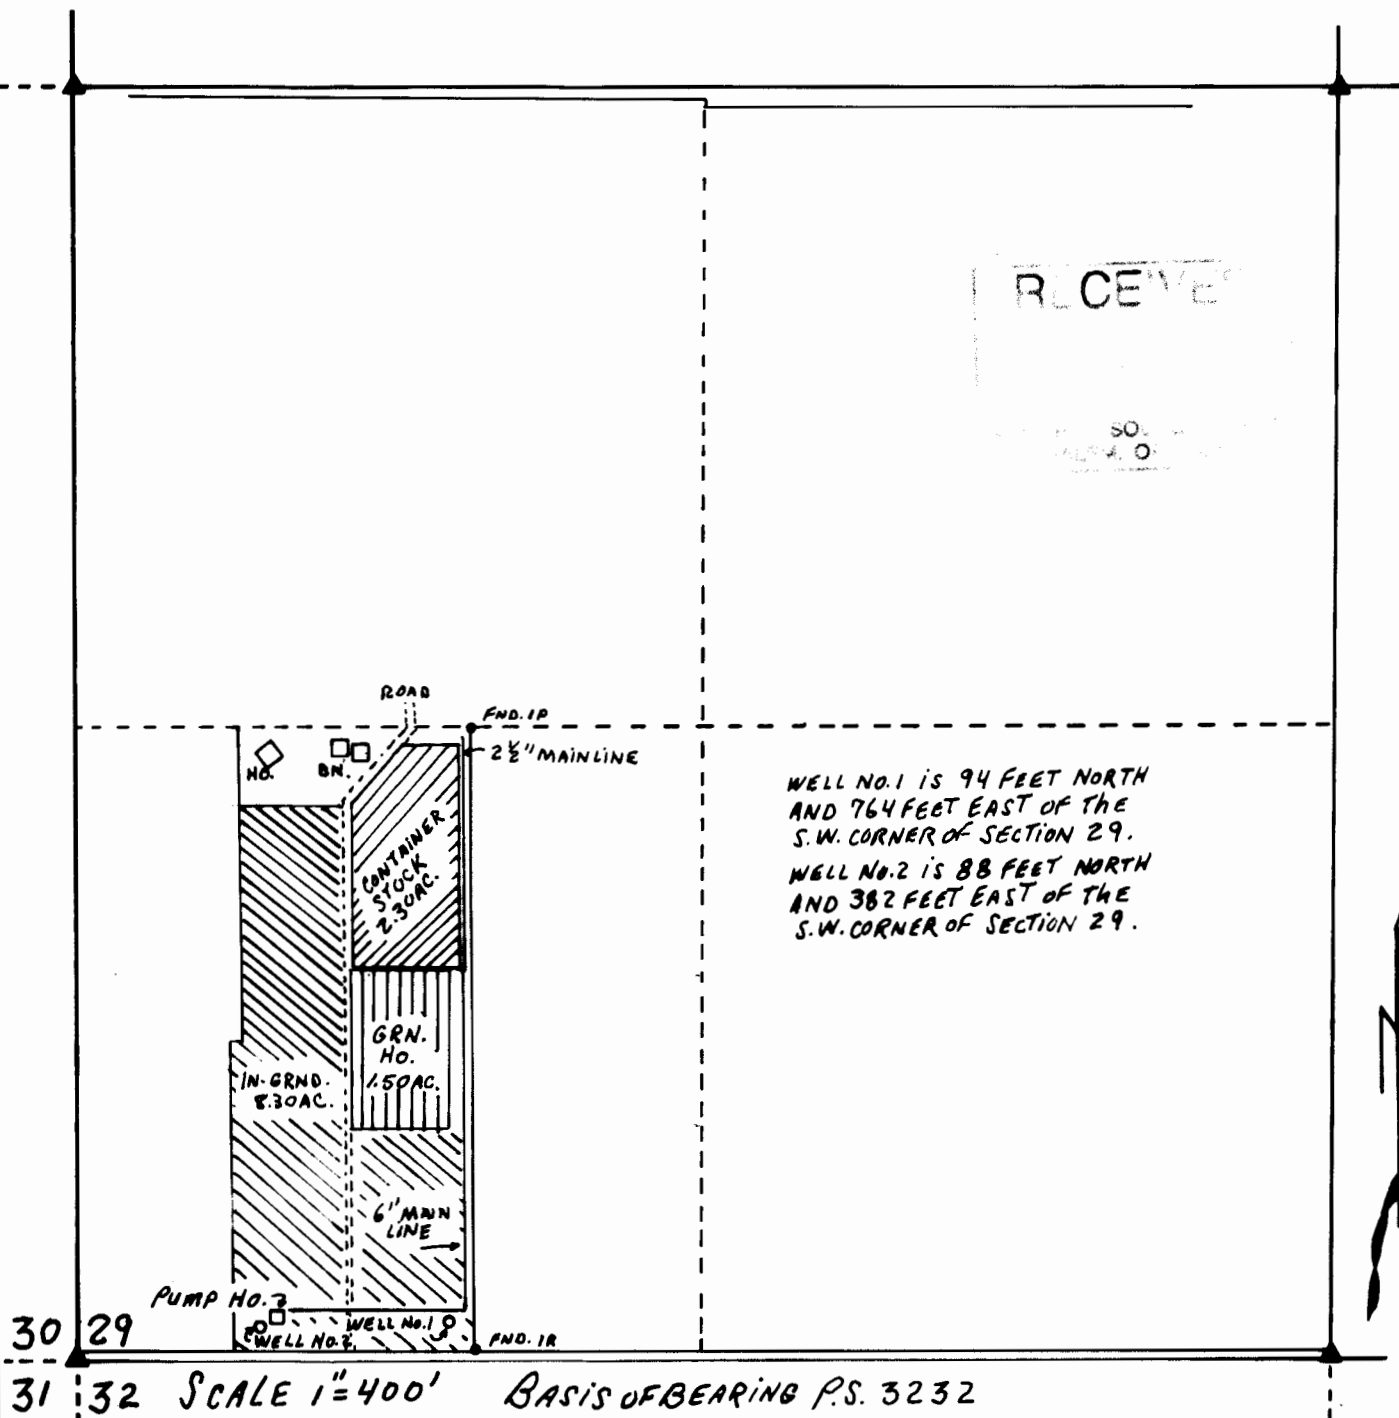

WELL NO. 1 IS 94 FEET NORTH
AND 764 FEET EAST OF THE
S.W. CORNER OF SECTION 29.
WELL NO. 2 IS 88 FEET NORTH
AND 382 FEET EAST OF THE
S.W. CORNER OF SECTION 29.

30 29
31 32 SCALE 1"=400' BASIS OF BEARING P.S. 3232

THIS MAP IS NOT INTENDED TO
PROVIDE LEGAL DIMENSIONS OR
LOCATIONS OF PROPERTY OWNERSHIP
LINES.

SURVEYED 5/31/2004

