

34 35
3 2



RECEIVED


SEP 27 2000

SCALE: 1" = 400'


WATER RESOURCES DEPT.
SALEM, OREGON

TAX LOT 701

WELL

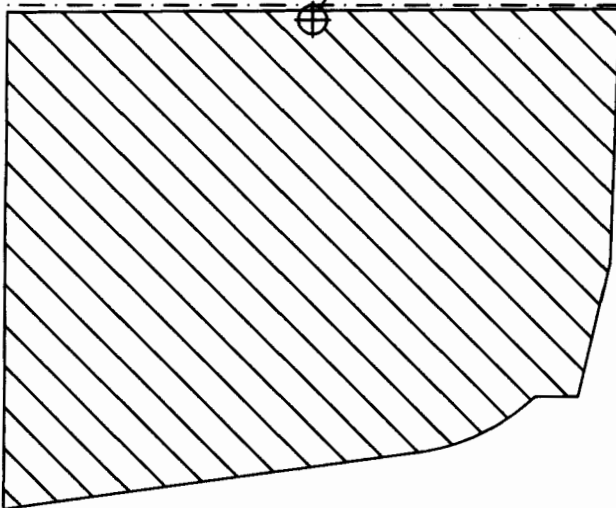

TAX LOT 702

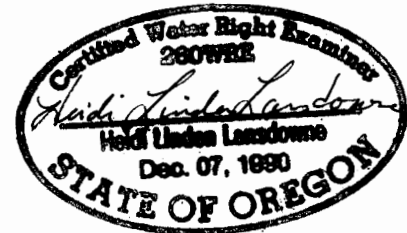

I, Heidi L. Lansdowne, Certified Water Right Examiner in the State of Oregon, hereby certify the above final proof map was prepared under my direct supervision.

This map is for the purpose of locating a water right only and has no intent to provide dimensions or locations of property ownership lines.

CLAIM OF BENEFICIAL USE FOR:

ROBERT KOCH
21111 N. W. SPRUCE AVENUE
REDMOND, OREGON 97756
(541)923-0602
PERMIT NO. G-12626

THE WELL IS LOCATED 650 FEET WEST
AND 1350 FEET SOUTH OF THE NORTHEAST
SECTION CORNER OF SECTION 3,
T15S, R12E, W.M., DESCHUTES
COUNTY, OREGON.



IRRIGATED AREA (26.8 ACRES)

IRRIGATION FOR TAX LOT 702
SECTION 3, T 15 S,
R 12 E, W.M., DESCHUTES
COUNTY, OREGON

LANDSDOWNE ENGINEERING ASSOCIATES

20568 KLAHANI DRIVE BEND, OR 97702

(503) 389-6901

SEPTEMBER 25, 2000

CLAIM OF BENEFICIAL USE- KOCH

SCALE 1" = 400'

DWG. KOCH