
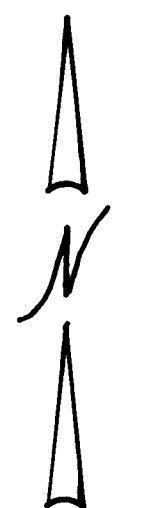


# T. 7 S. R. 2 W., W.M.

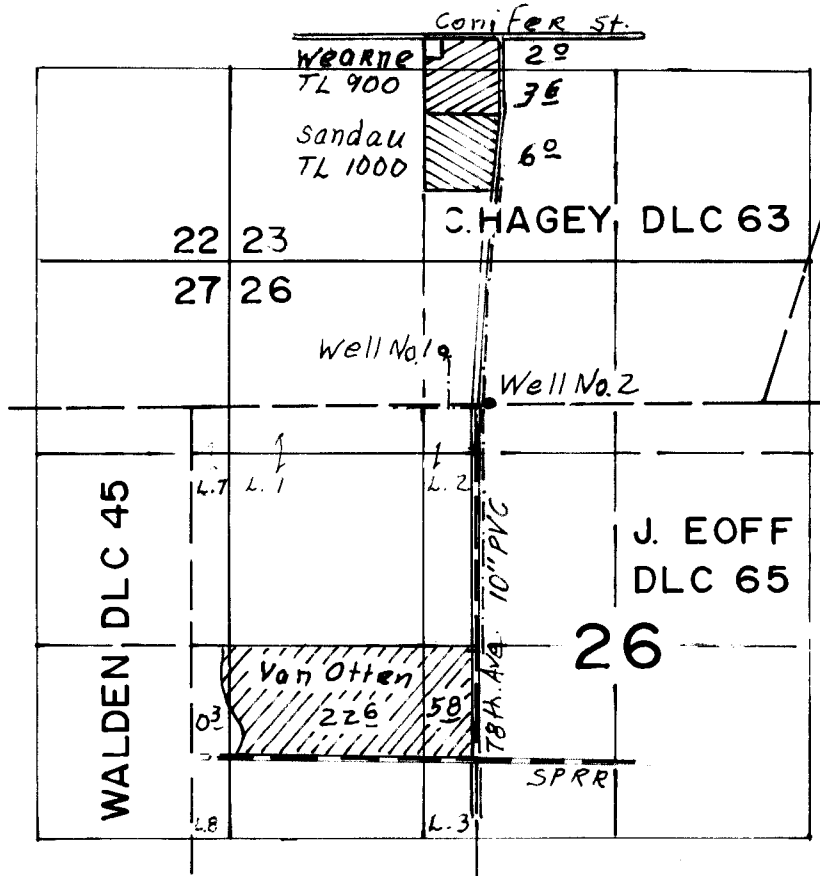

Scale  
4" = 1 Mi

Well No. 1 Loc. 336' N & 200' W FROM NW COR. DLC 65  
 Well No. 2 Loc. 58' E FROM NW COR. DLC 65

## FINAL PROOF SURVEY UNDER

Application No. ~~G-14039~~ Permit No. ~~G-13019~~  
 IN NAME OF

**DAN SANDAU**

Surveyed Oct. 19 1999, by .....

