


T 30 S, R 6 W, WM

SCALE 1" = 1320'

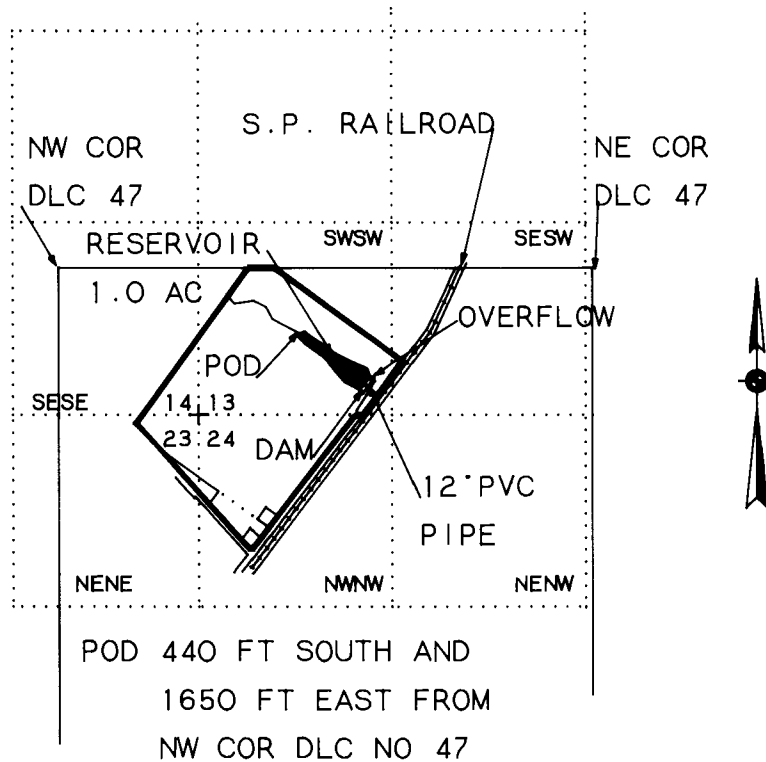

FINAL PROOF SURVEY
UNDER

Application No. ^{R. 70624} 70625 Permit No. 50001

IN NAME OF

GLENBROOK NICKEL COMPANY

Surveyed July 27, 1990 BY M E Farr

