


T. 8 S. R. 40 E. W. M.

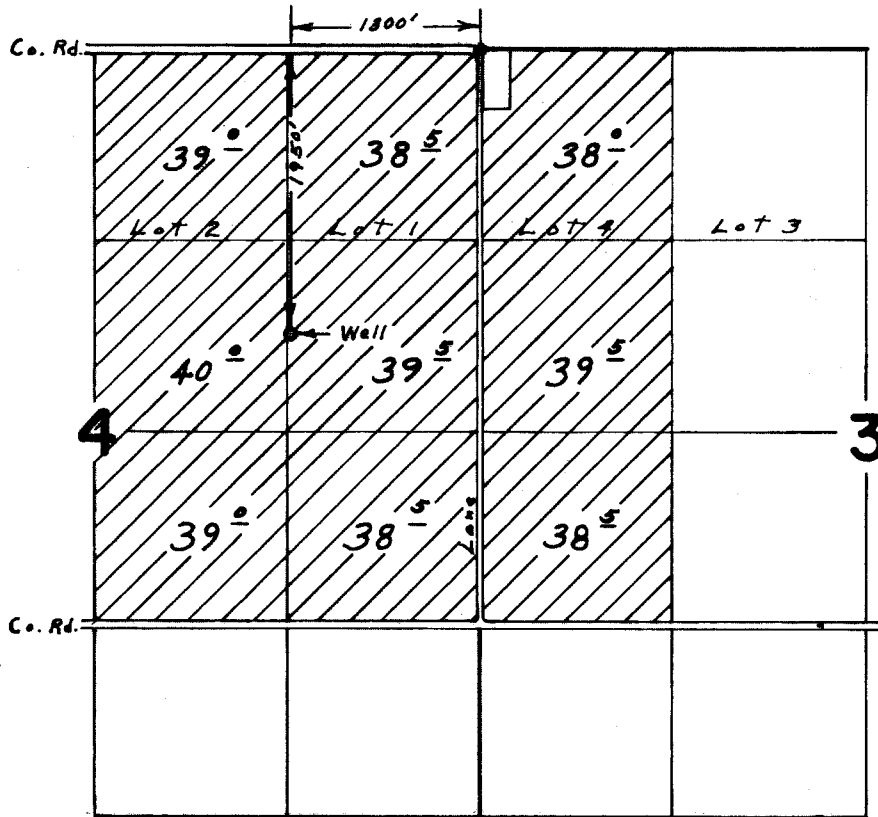

FINAL PROOF SURVEY UNDER

Application No. G-3089. Permit No. G-2886.
 IN NAME OF
KENNETH W. & DELMA D. MILES
 Surveyed July 15, 1970, by L. E. Gould.