
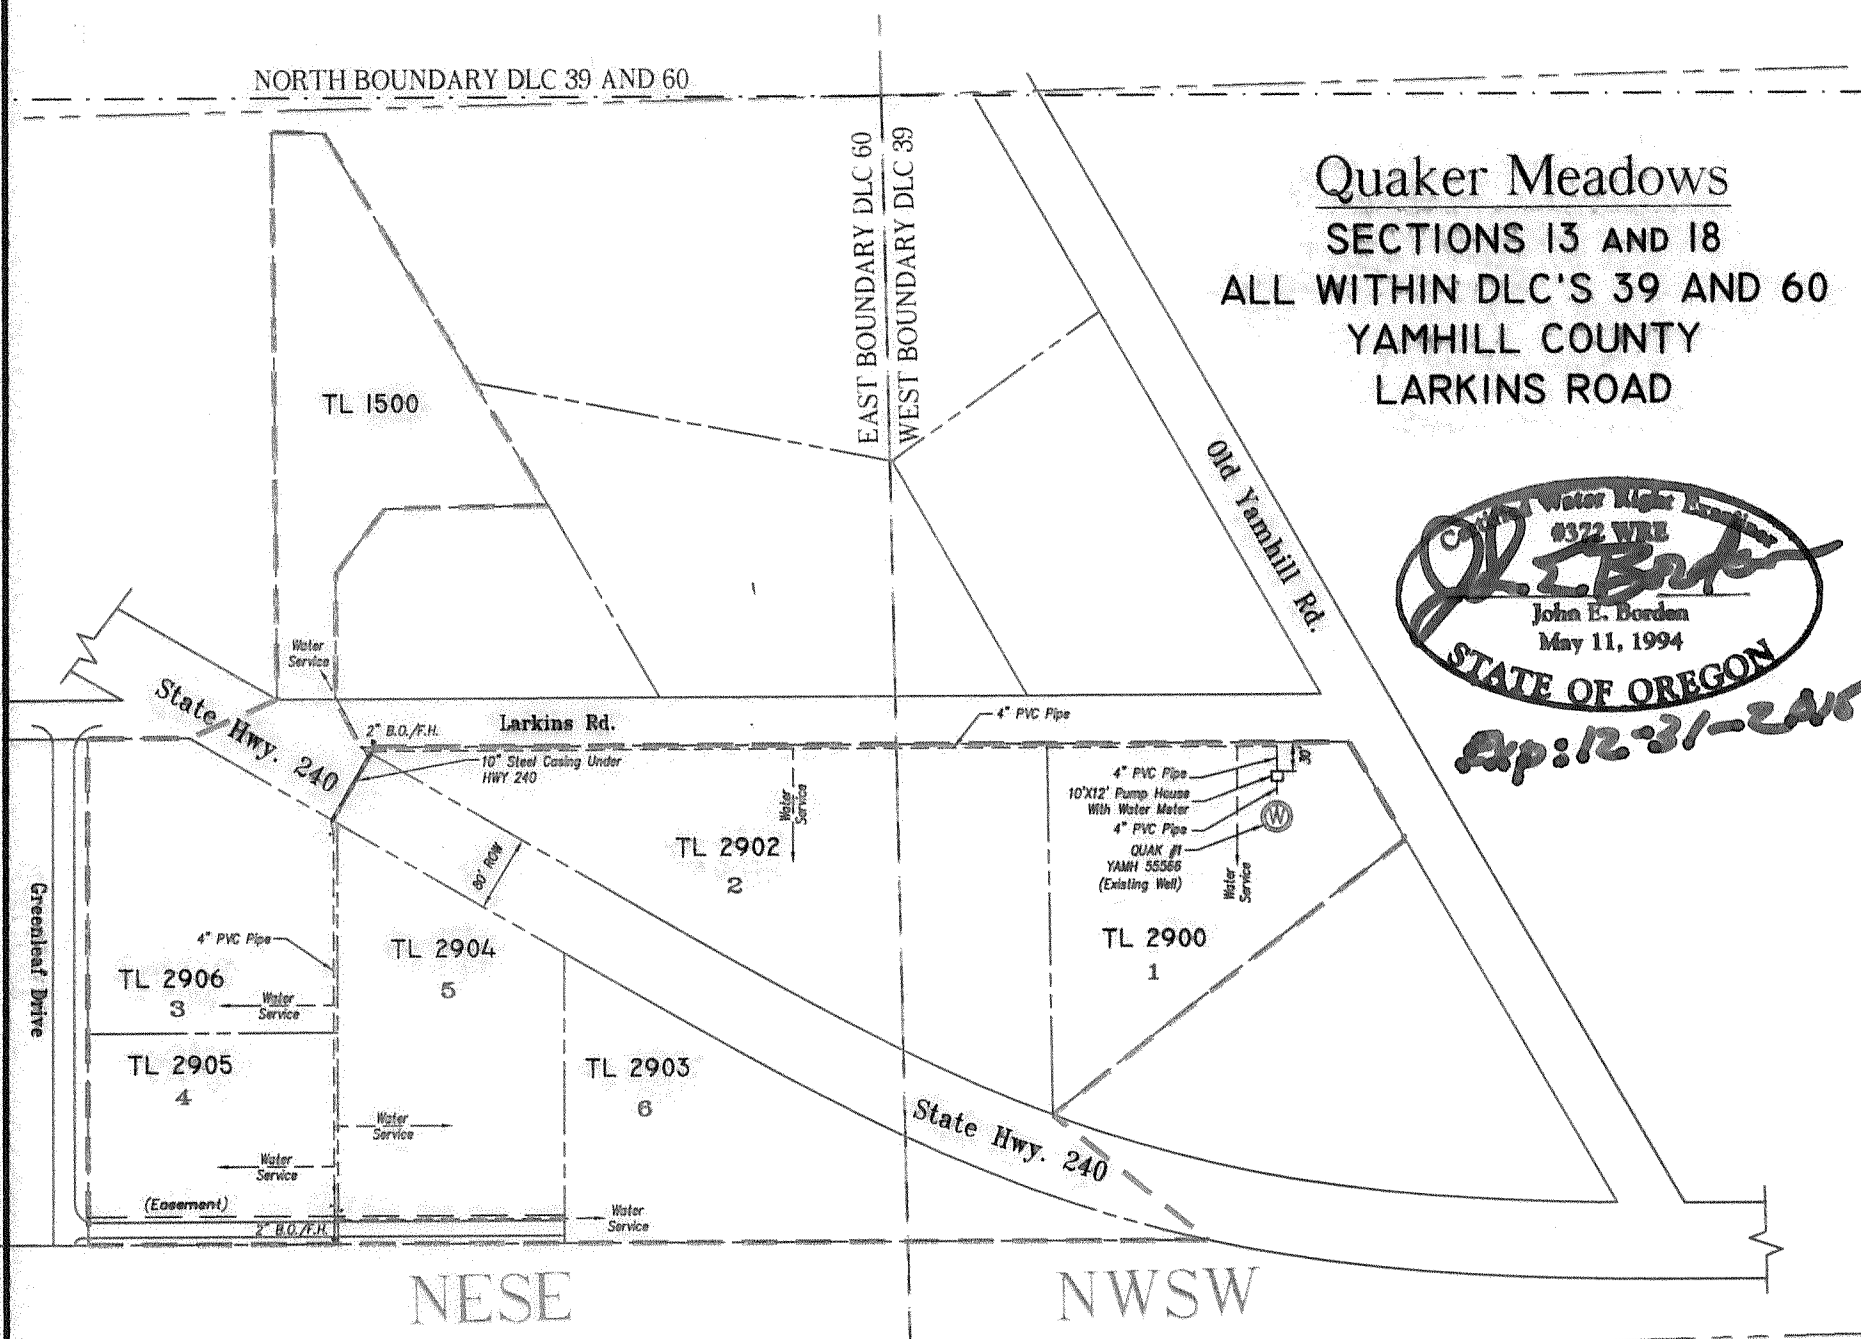


COBU MAP # 831

T. 3S. R3W. and T.3S. R2W., W.M.

Quaker Meadows
 SECTIONS 13 AND 18
 ALL WITHIN DLC'S 39 AND 60
 YAMHILL COUNTY
 LARKINS ROAD

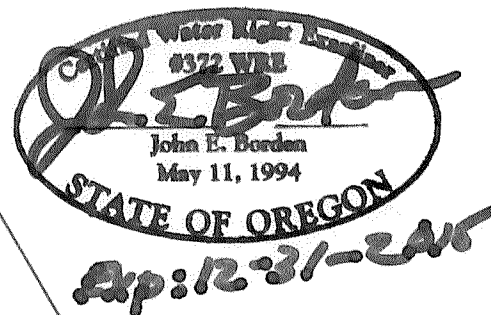

NESE NWSW


SESE

T. 3S. R.3W
 T. 3S. R.2W

NOTES:

P.O.A. IS LOCATED 1887 FEET NORTH AND 353 FEET EAST FROM THE SW CORNER OF SECTION 18

PREPARATION OF THIS MAP IS FOR THE PURPOSE OF IDENTIFYING THE LOCATION OF THE WATER RIGHT ONLY. THERE IS NO INTENT TO PROVIDE DIMENSIONS OR LOCATION OF PROPERTY OWNERSHIP LINES.

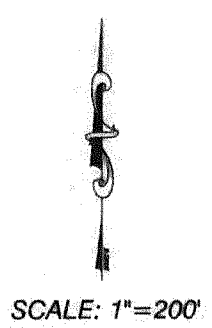

LEGEND

- PROPERTY LINE
- ROADWAY
- USGS GRID
- DLC BOUNDARY
- QUASI-MUNICIPAL BOUNDARY
- ⊙ SECTION CORNER
- ⊙ WELL (P.O.A.)
- MAIN LINE 4-INCH PVC PIPE

"To" Lands for T-11531

RECEIVED

MAY 27 2014

WATER RESOURCES DEPT
 SALEM, OREGON

