


T. 17 S., R. 23 E., W. 1 M.

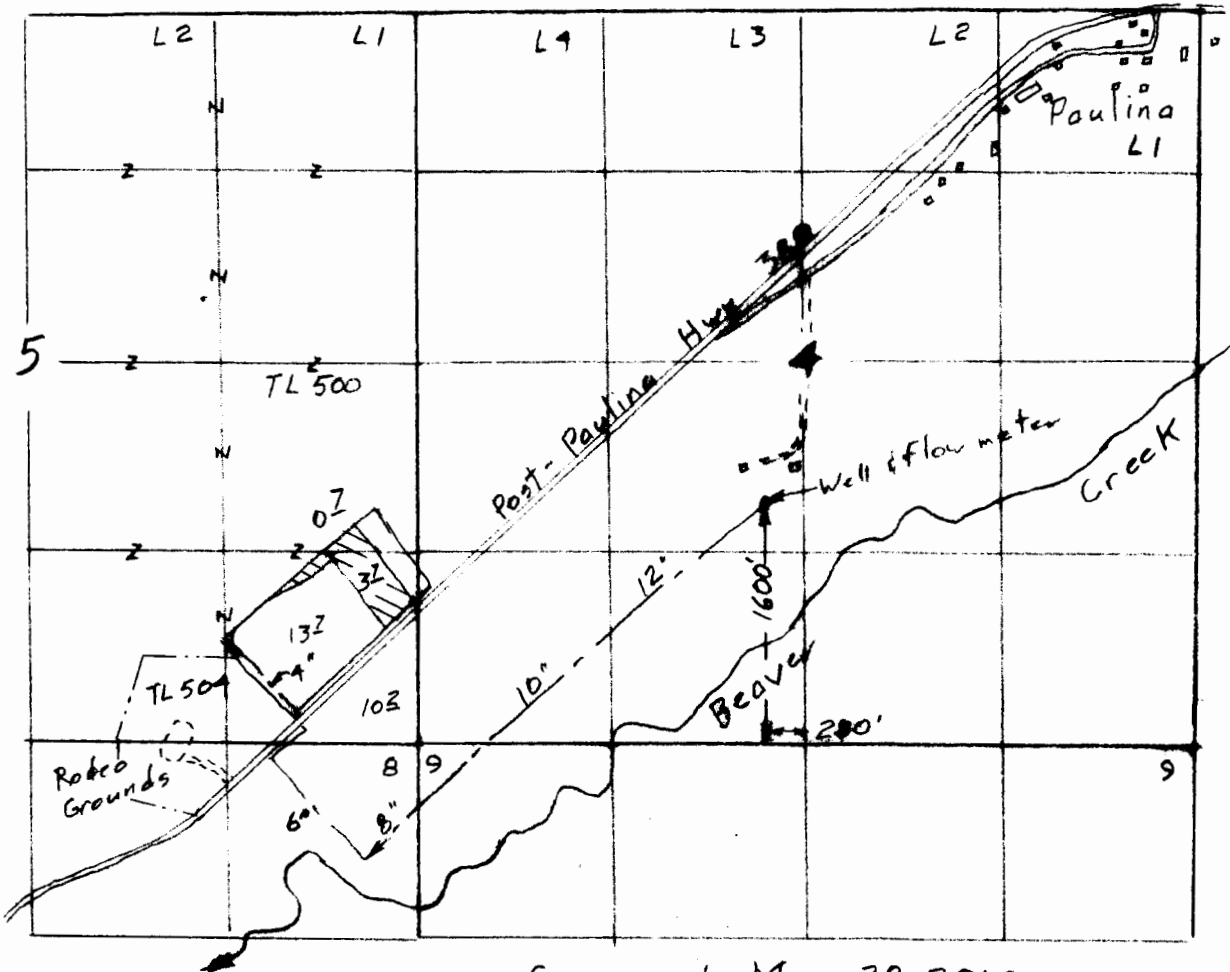

Surveyed May 28, 2014

Scale 1" = 1320'  
(4" = 1 mile)


T-8574

⊗ To 49 acres

Claim of Beneficial Use Map  
for  
Hermreck at the Y Ranch



This map is for the purpose of  
locating a water right only  
and has no intent to provide  
legal dimensions or the location  
of property lines.

 

SALE