
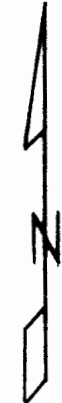


RECEIVED BY OWRD

SEP 11 2014

SALEM, OR

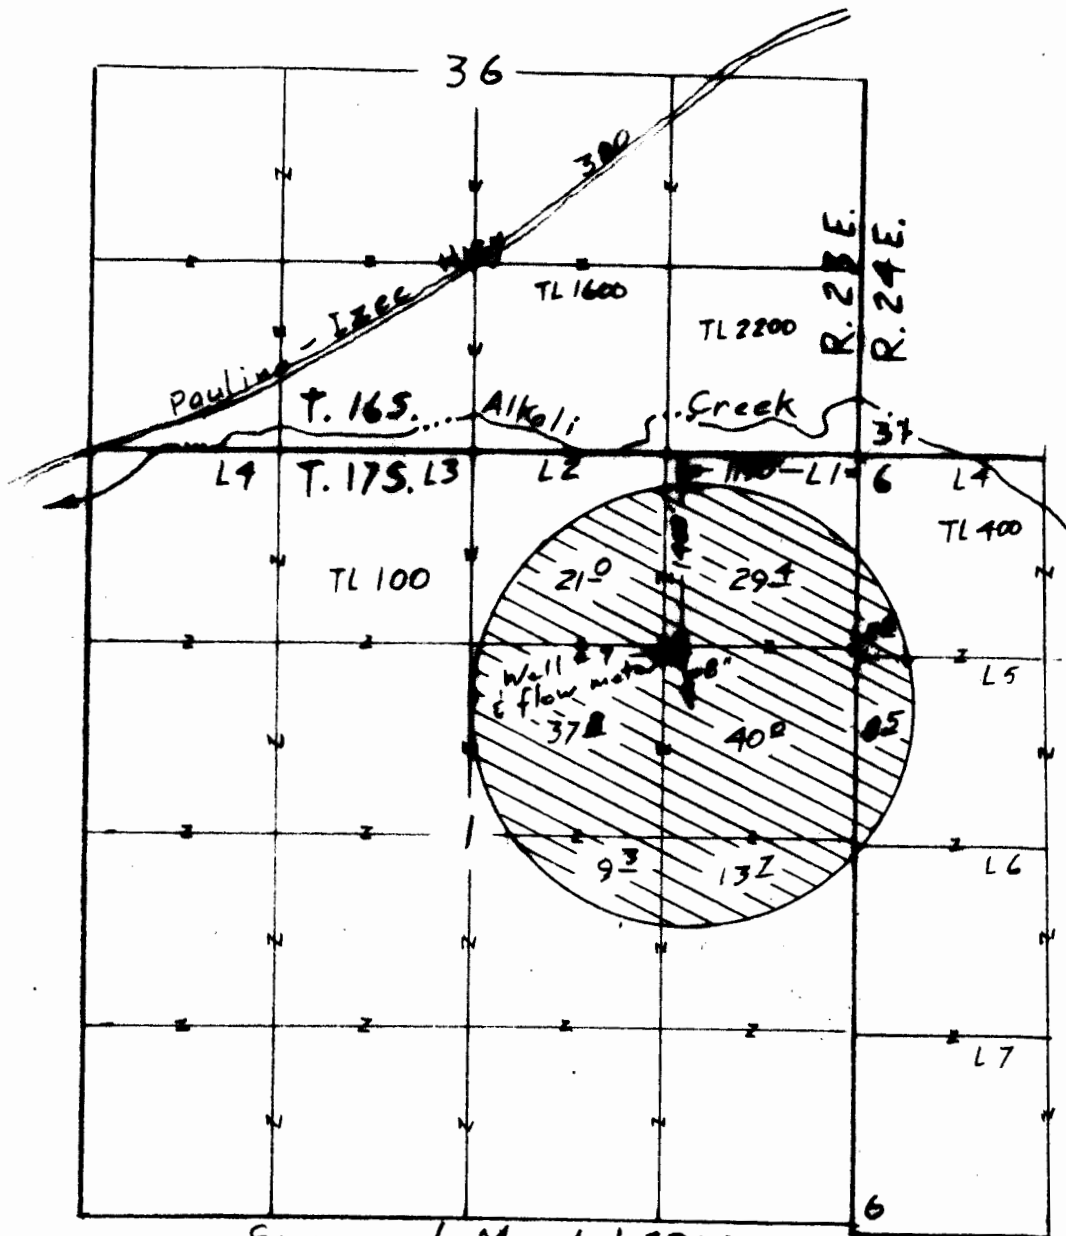

Scale 1" = 1320'
(4" = 1 mile)

⊘ 162± acres

Surveyed March 1, 2014

App G-17217
Per G-16769

Claim of Beneficial Use Map
for
Hermreck at the V Ranch, LLC



Renewal Dec 31, 2015

This map is a copy of
[Redacted]

OWRD SURVEYS, LLC
 2002 Arnold Rd
 Bend, OR 97702
 (541) 382-7391