



T. 16 S., R. 23 E., W.M.

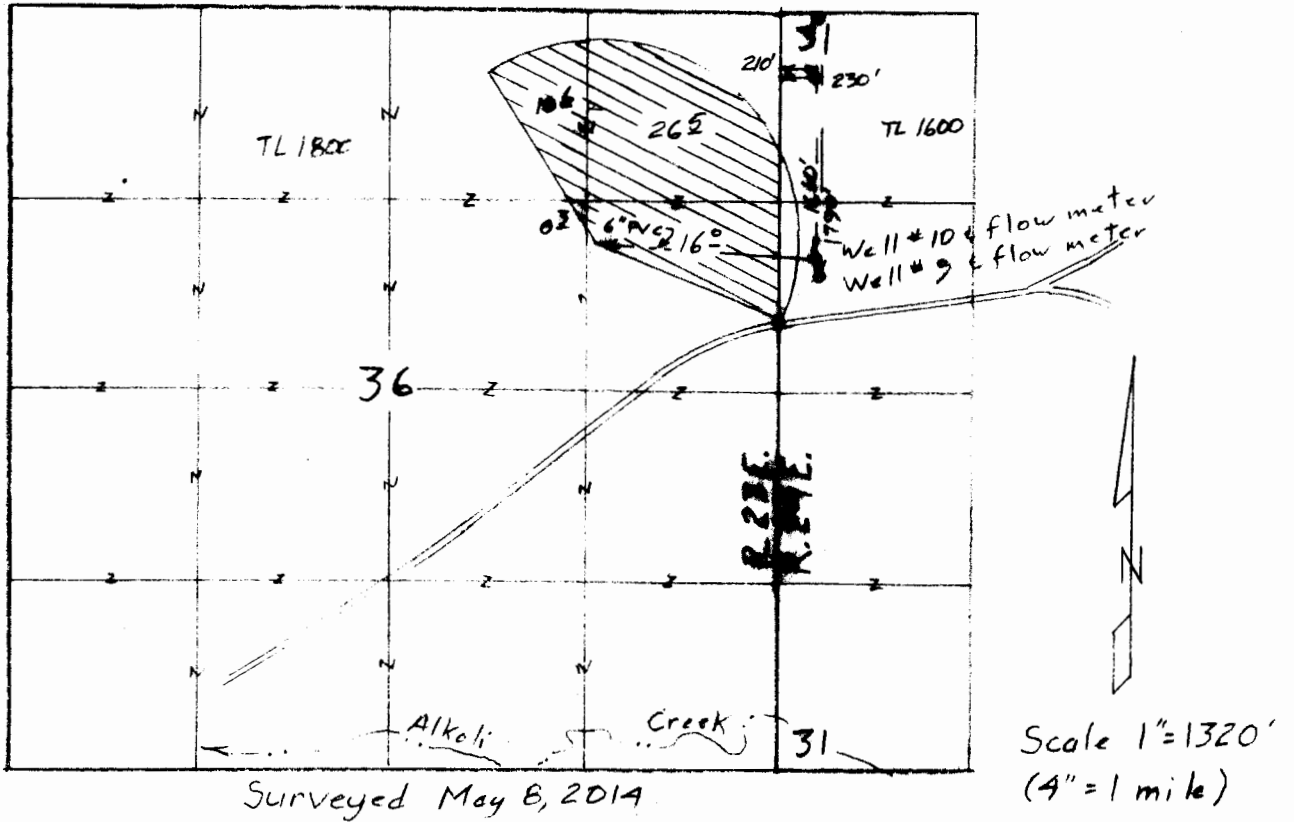

⊗ 53± acres

App G-16592  
Per G-16911  
PA T-11389

### Claim of Beneficial Use Map for Hermreck at the Y Ranch, LLC

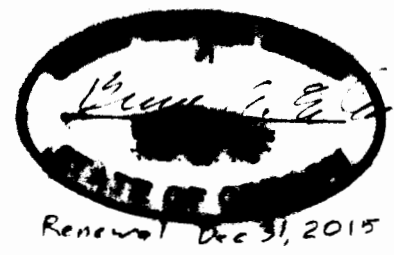

SELF-DECLARED

This map is for the purpose of  
claiming water rights only  
and does not constitute a  
legal description or the location  
of property lines.

**ESTUS SURVEYS, LLC**

60002 Arnold Rd  
Bend, OR 97702  
(541) 362-7391