

RECEIVED BY OWRD



OCT 24 2014

SALEM, OR

CLAIM OF BENEFICIAL USE MAP

FOR
RON GILLEN

SECTION 35
TOWNSHIP 15 SOUTH RANGE 18 EAST
CROOK COUNTY, OREGON

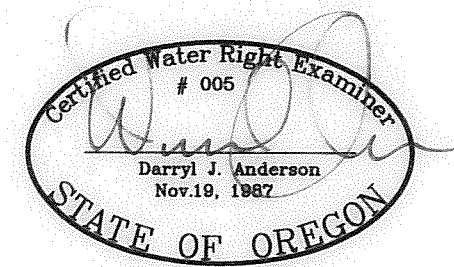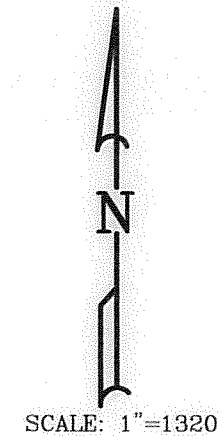

RENEWAL 12/31/15

LEGEND

- SECTION LINE
- 1/4 SECTION LINE
- 1/16 SECTION LINE



AREA SUBMERGED



AREA IRRIGATED FROM RESERVOIR
UNDER PERMIT 53252

APPLICATION NO. R-80202

PERMIT NO. R-12236

NOTE:

PREPARATION OF THIS MAP IS FOR IDENTIFYING PROPOSED
WATER RIGHTS ONLY. IT HAS NO INTENT TO PROVIDE
LOCATIONS OR DIMENSIONS OF PROPERTY BOUNDARIES.


REVISION	BY
7/25/2014	RC
10/21/2014	RC

ANDERSON ENGINEERING
AND SURVEYING, INC.
P.O. BOX 28
LAKEVIEW, OREGON
97630
(541) 947-4407
FAX: 947-2321

FOR:
RON GILLEN
P.O. BOX 6
POST, OREGON
97762

CLAIM OF BENEFICIAL USE
APPLICATION NO. R-80202
PERMIT NO. R-12236

DATE:	5/11/2012
SCALE:	1"=1320'
DWG. BY:	R.C.
JOB:	2011-118
FILE:	2011-118
SHEET:	1 OF 1

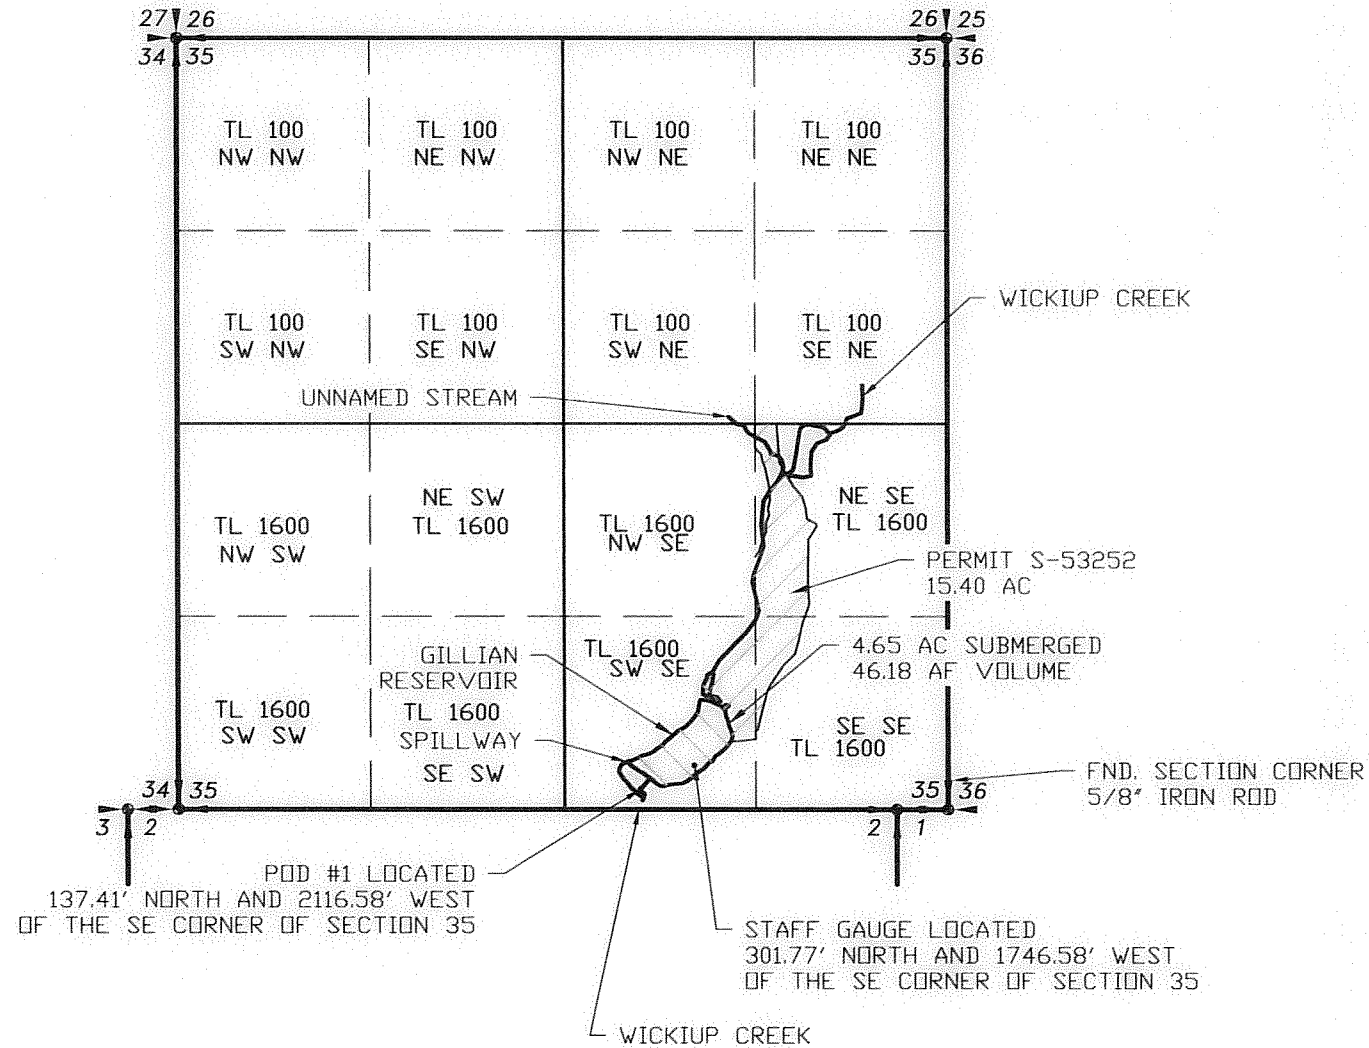

COBU MAP # 850