
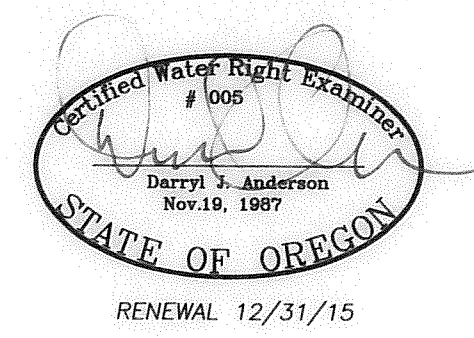


849

RECEIVED BY OWRD
OCT 24 2014
SALEM, OR

CLAIM OF BENEFICIAL
USE MAP
FOR
RON GILLEN
SECTION 35
TOWNSHIP 15 SOUTH RANGE 18 EAST
CROOK COUNTY, OREGON

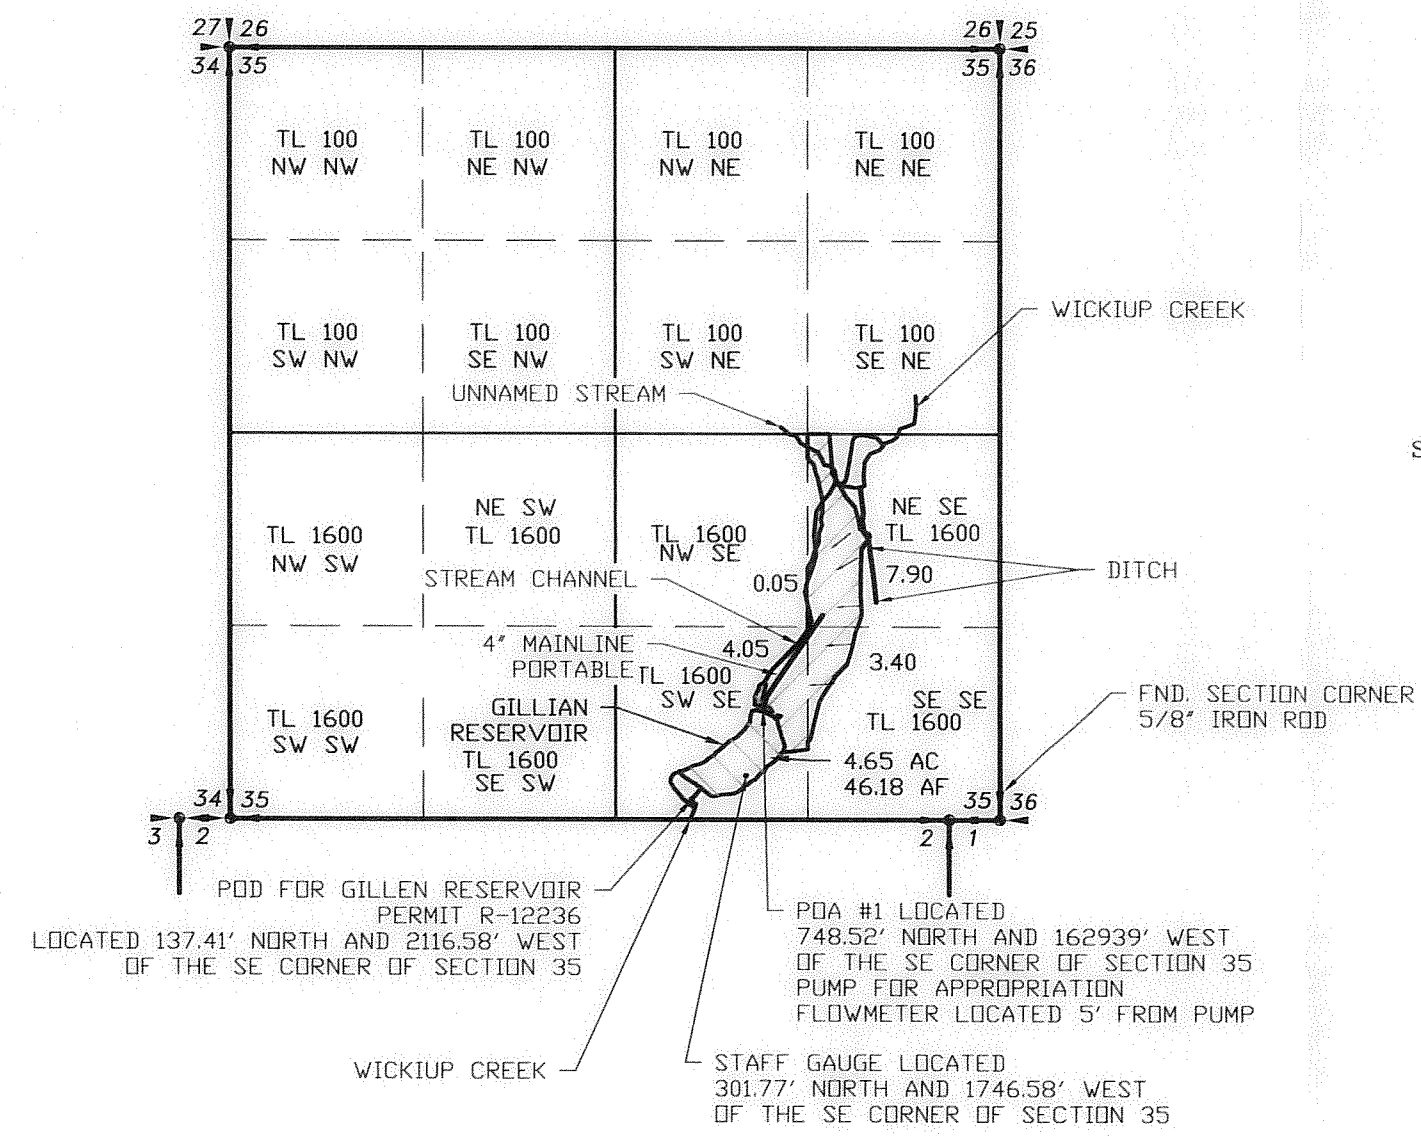

- LEGEND**
- SECTION LINE
 - 1/4 SECTION LINE
 - 1/16 SECTION LINE
 - FLOW DIRECTION
 - PLACE OF USE - WILDLIFE, STOCKWATERING AND IRRIGATION - GILLEN RESERVOIR
 - PLACE OF USE - SUPPLEMENTAL IRRIGATION

APPLICATION NO. S-80203
PERMIT NO. S-53252

NOTE:
PREPARATION OF THIS MAP IS FOR IDENTIFYING PROPOSED
WATER RIGHTS ONLY. IT HAS NO INTENT TO PROVIDE
LOCATIONS OR DIMENSIONS OF PROPERTY BOUNDARIES.

COBU MAP # 849

REVISION	BY
7/25/2014	RC
10/21/2014	RC

ANDERSON ENGINEERING
AND SURVEYING, INC.
P.O. BOX 28
LAKEVIEW, OREGON 97630
(541) 947-4407
FAX: 947-2321

FOR:
RON GILLEN
P.O. BOX 6
POST, OREGON
97752

CLAIM OF BENEFICIAL USE
APPLICATION NO. S-80203
PERMIT NO. S-53252

DATE:	5/11/2012
SCALE:	1"=1320'
DWG. BY:	R.C.
JOB:	2011-118
FILE:	2011-118
SHEET:	1 OF 1