


CLAIM OF BENEFICIAL USE
FINAL PROOF MAP
LOCATED IN THE SE $\frac{1}{4}$ NW $\frac{1}{4}$ OF SECTION 12
TOWNSHIP 30 SOUTH, RANGE 15 WEST, W.M.
COOS COUNTY, OREGON
APPLICATION G-14812 PERMIT G-13651

PREPARED FOR: GARY L. CANNON
PREPARED BY: DENNIS GOUDE
DATE PREPARED: APRIL 30, 2008

Scale 1"=400'

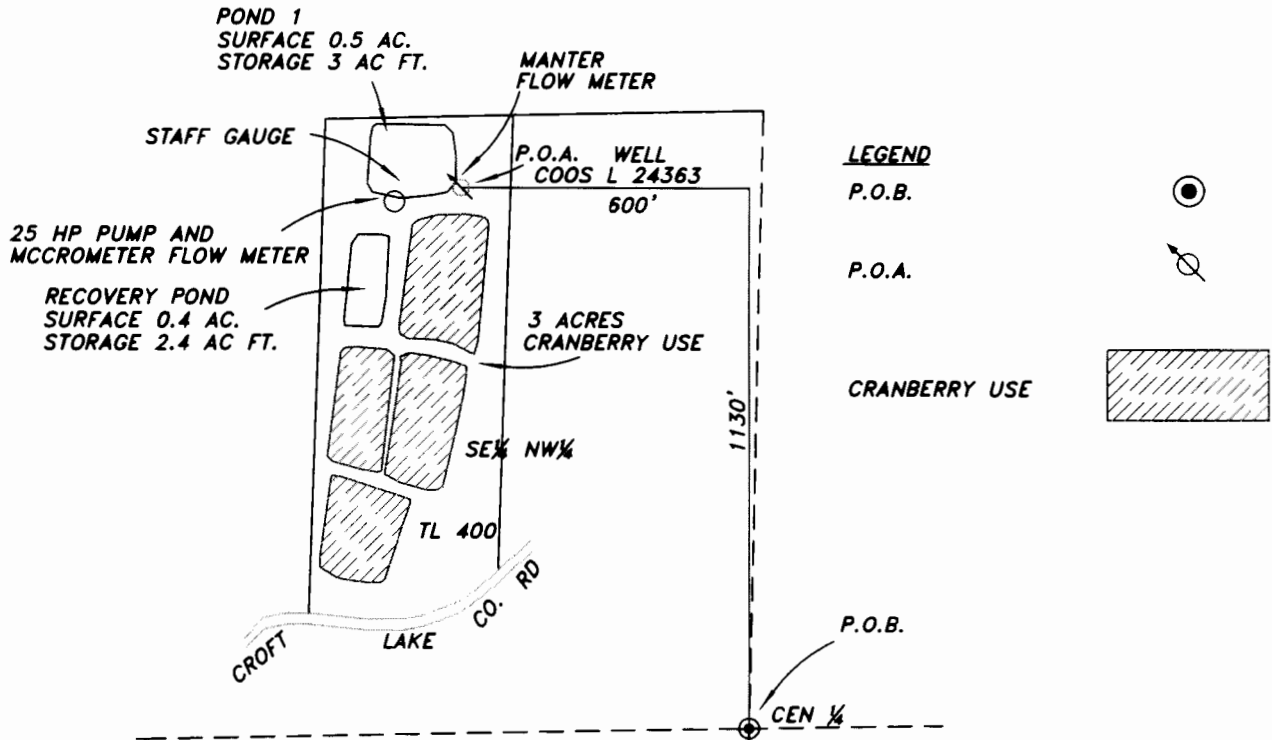

NOTE:
PERMIT AUTHORIZES CRANBERRY OPERATIONS ON 5.0 ACRES.
SURVEY FOUND THAT ONLY 3 ACRES HAVE BEEN DEVELOPED
THEREFORE THE CLAIM OF BENEFICIAL USE IS FOR 3.0 ACRES.

NOTE:
THE RECOVERY POND IS SITUATED TO CATCH THE RUNOFF FROM
THE CRANBERRY BOGS AND THEN IS PUMPED TO THE STORAGE
POND NEAR WELL L 24363.

NOTE:
THE POINT OF APPROPRIATION IS LOCATED 600 FEET WEST
AND 1130 FEET NORTH FROM THE CENTER $\frac{1}{4}$ CORNER OF
SECTION 12. ALL MEASUREMENTS WERE TAKEN WITH AN
ELECTRONIC HAND HELD DISTANCE MEASURE AND COMPASS.

LEGEND

P.O.B.

P.O.A.

CRANBERRY USE



EXPIRES 12/31/2009

RECEIVED

JUL 07 2008

WATER RESOURCES DEPT
SALEM, OREGON

EXAMINERS DISCLAIMER STATEMENT
The preparation of this map was for the purpose of
identifying the location of the Water Right only and
has no intent to provide dimensions or location of
property ownership lines.

Stuntzner Engineering
& Forestry, L.L.C.
ENGINEERING • LAND SURVEYING • FORESTRY
PLANNING • WATER RIGHTS
700 North 4th St.
Post Office Box 115
Coos Bay, Oregon 97420
Phone: (541) 867-2872
Fax: (541) 867-0660