


T.23S. R.8W., W.M

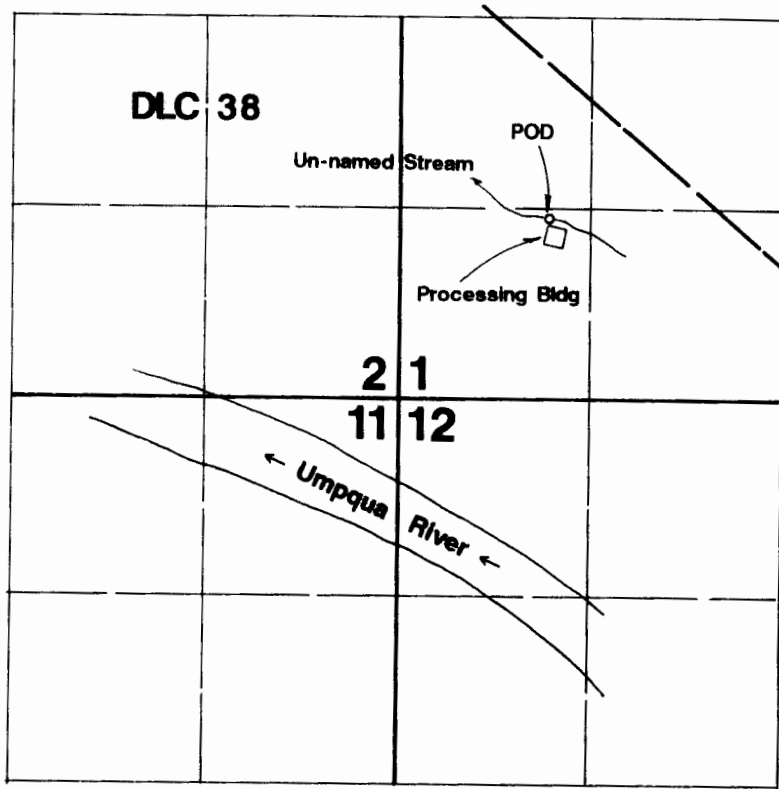

POD is located 1230'N & 1025'E from SW corner of Section 1.

RECEIVED

SEP 29 1998

WATER RESOURCES DEPT
SALEM, OREGON

Final Proof Survey

Application #: S-80123 Permit #: S-52554

In Name Of

Oregon Department of Forestry

Surveyed on August 21, 1998 by JM Schuette

This Map Was Prepared For The Purpose Of Identifying The Location Of A Water Right Only And Is Not Intended To Provide Legal Dimensions Or Location Of Property Ownership Lines.

