


HE 527

Sturman
T1S R10E S9
8495 Hwy 35
Mt. Hood, OR 97041

NA

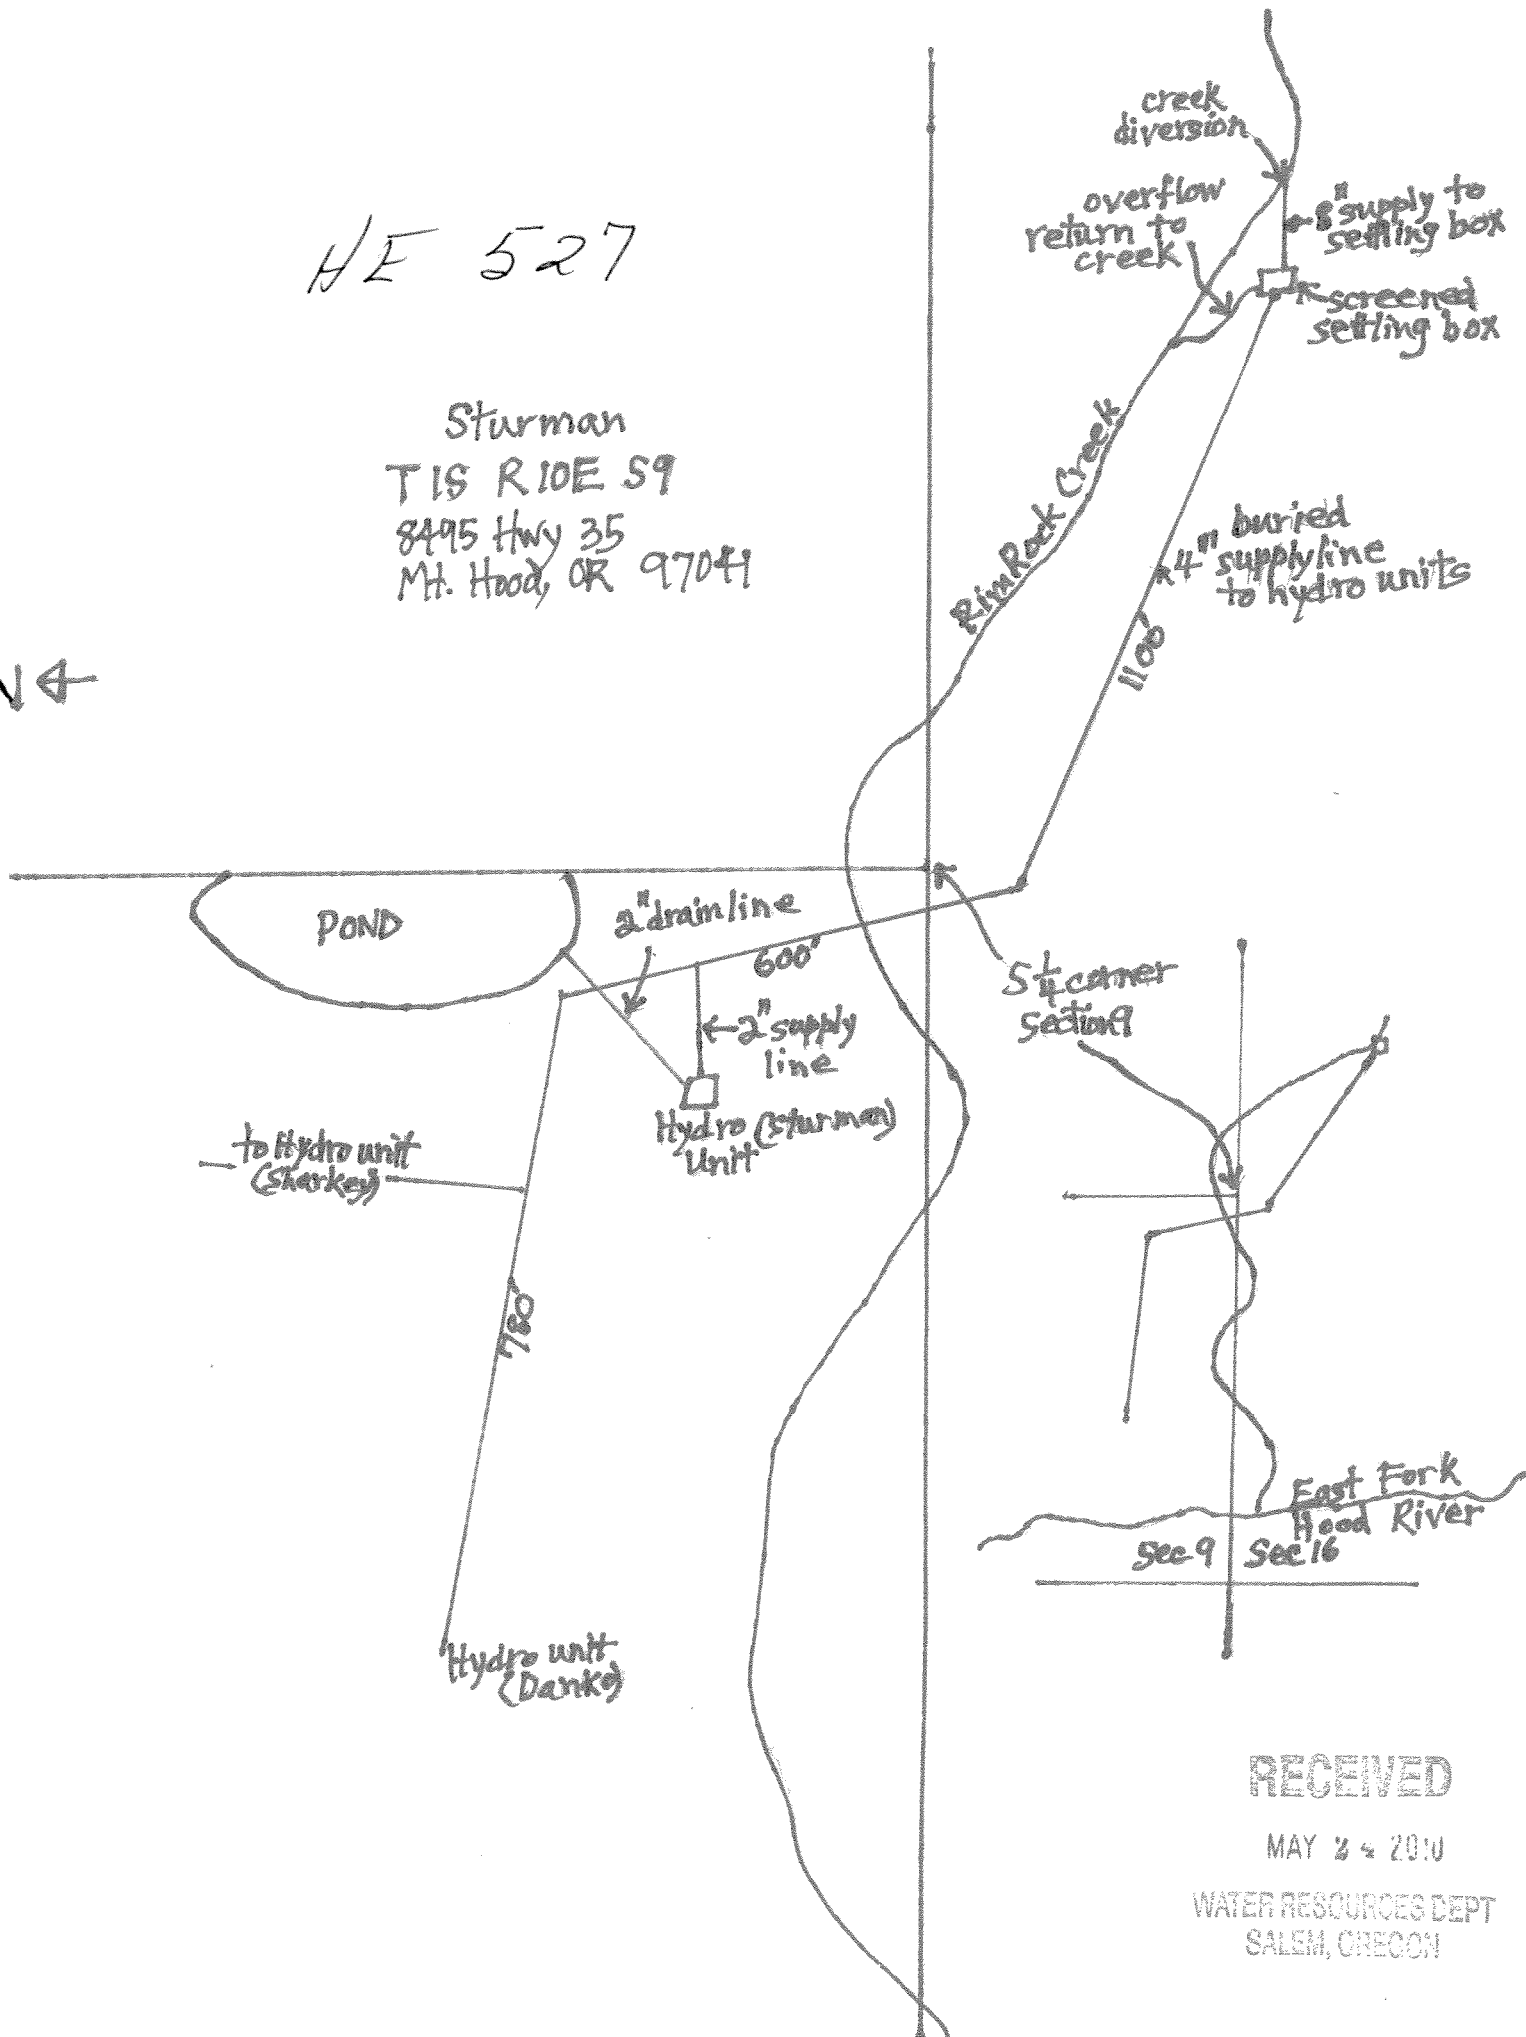


RECEIVED

MAY 24 2010

WATER RESOURCES DEPT
SALEM, OREGON

HE 528

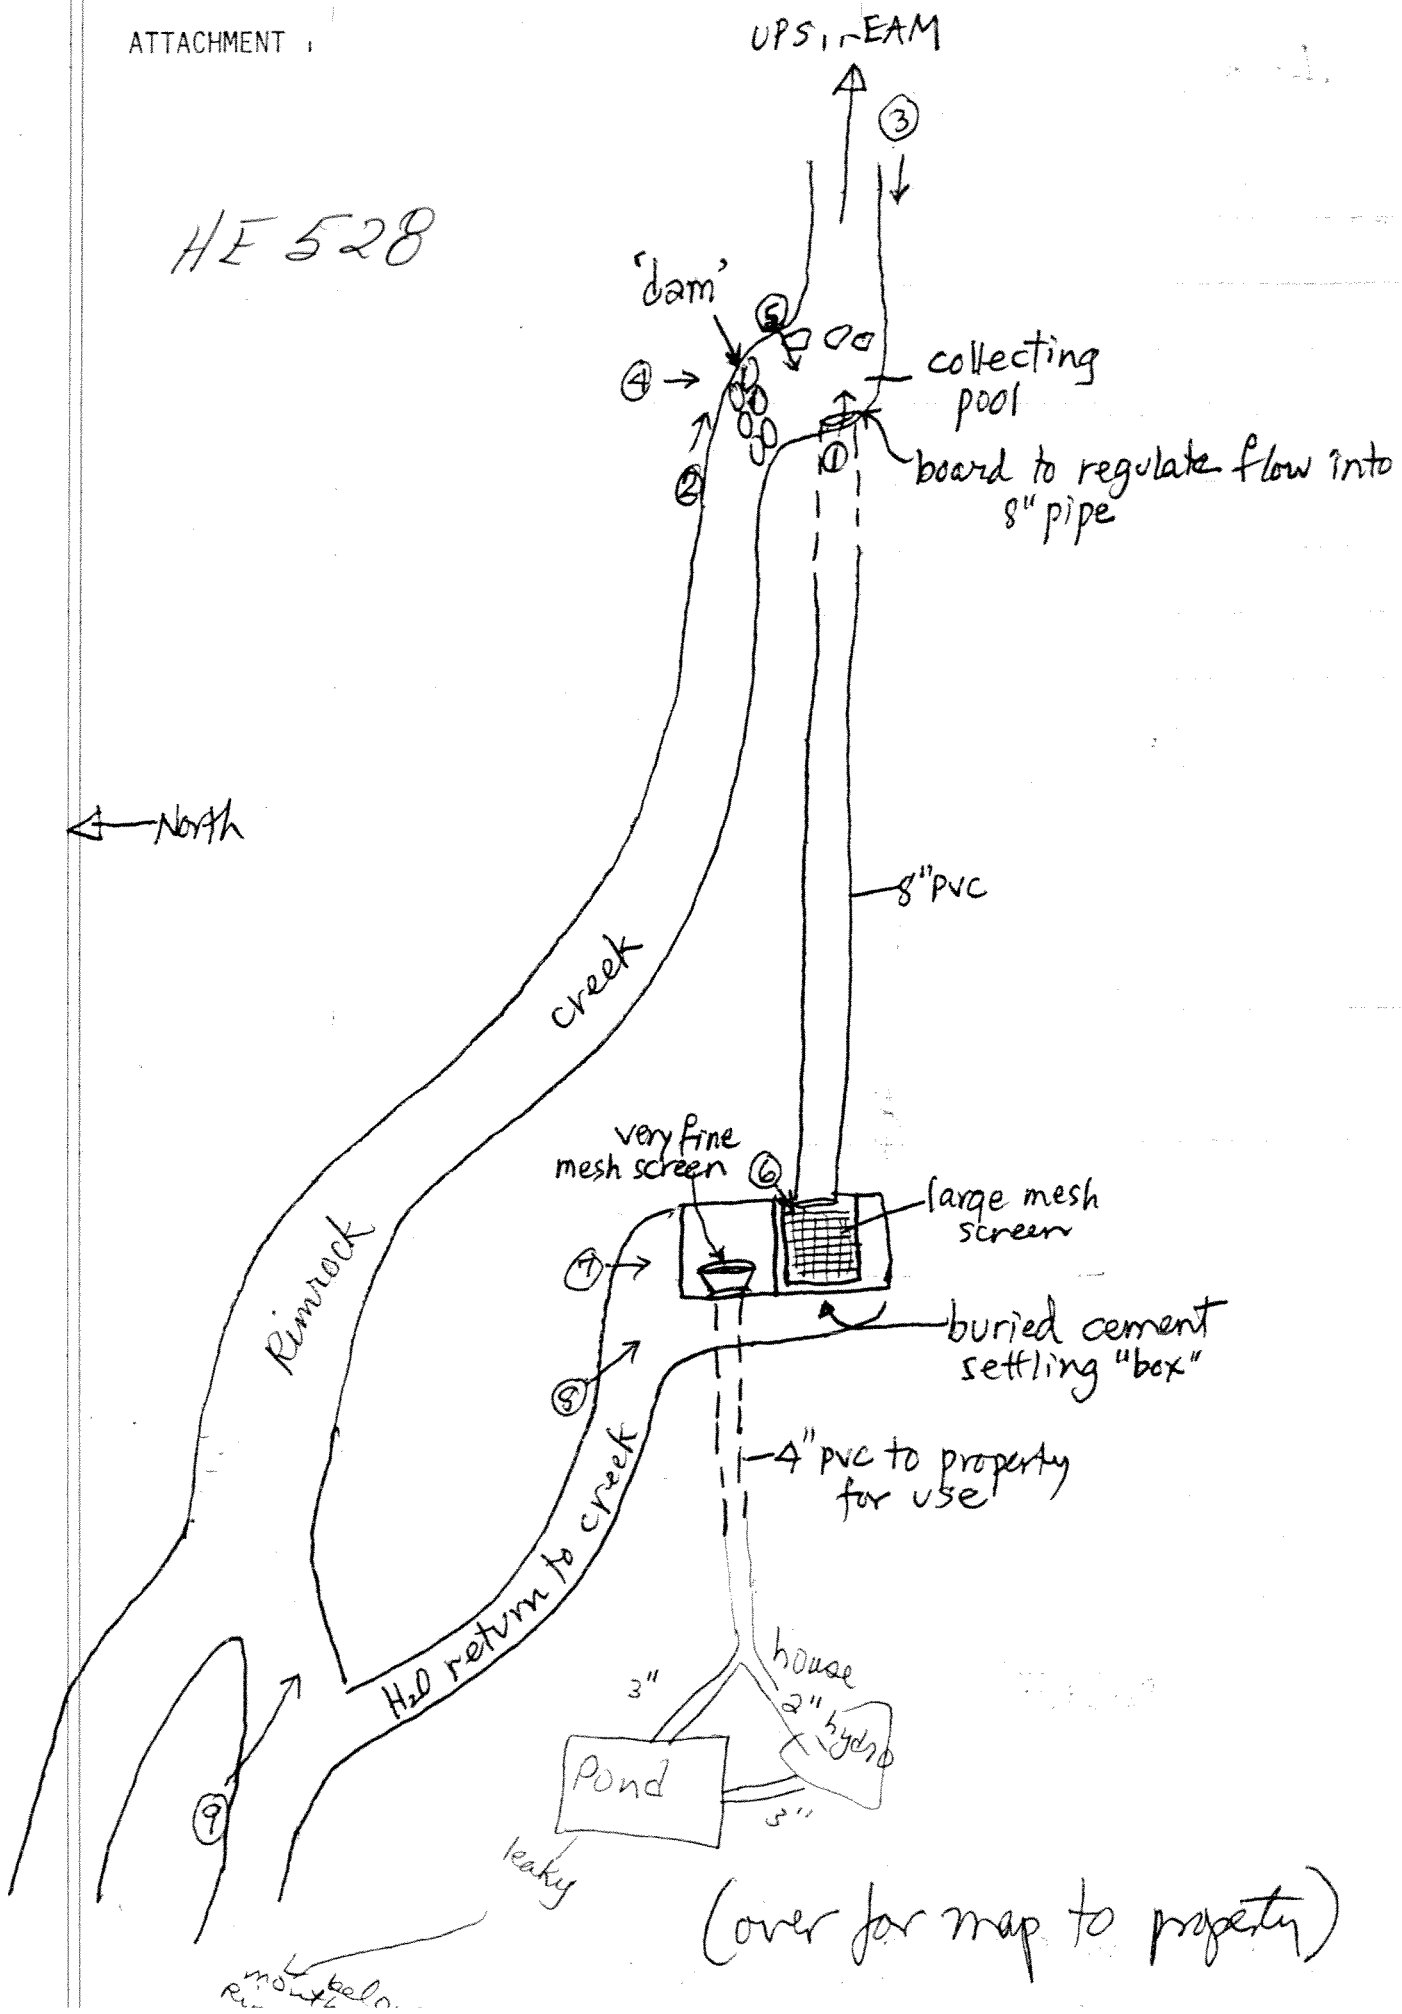

HE 529
DANKO
6/2010

Hood River County
Township 1S
Range 10E

Diversion point

North
1" = 250'

Section 9

Section 16
(owned by
Division of
State Lands)

4" pvc pipe for
-irrigation
-domestic
-pond
-hydro

5/4 corner
Section 9


POND

Sharkey
home

Sturman
home

Danko
hydro
unit
Danko
home

POND

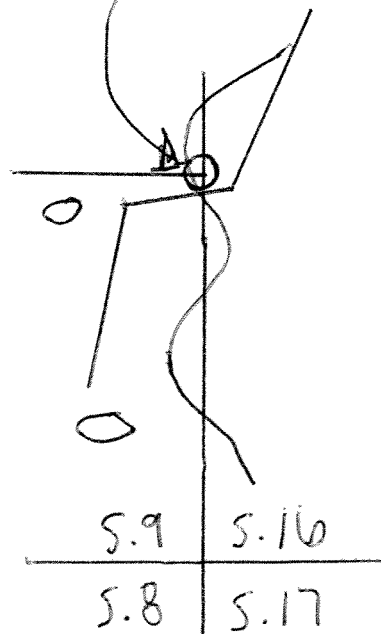

RECEIVED

JUN 17 2010

WATER RESOURCES DEPT
SALEM, OREGON